


T.23S. R.6E. Section 14, W.M.

(Section and 16th Lines are Unsurveyed and Shown Only in Approximate Locations)

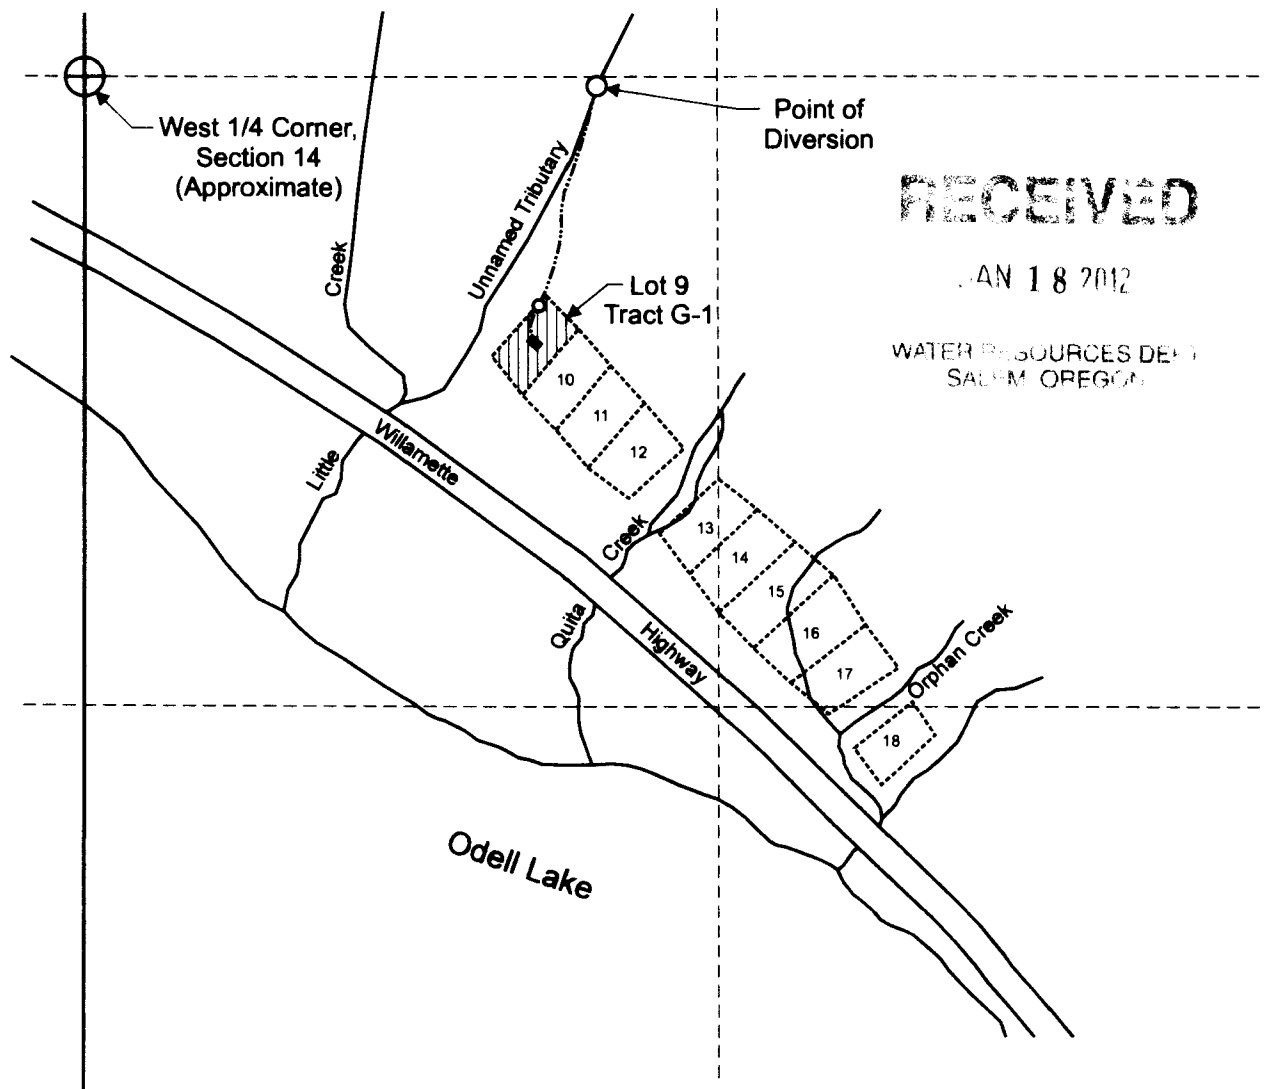


RECEIVED

JAN 18 2012

WATER RESOURCES DEPT


Point of diversion is located 440 feet north and 110 feet east from the most northerly corner, Lot 9, Tract G-1.

-  Area of use for Human Consumption
-  Tax lot boundary
-  Cabin Location
-  Meter Location
-  Mainline

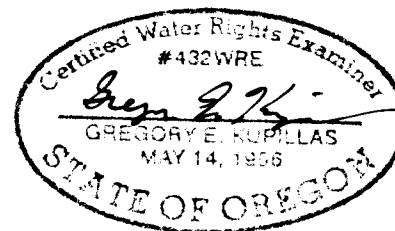

EXPIRATION DATE 6/30/2013

Scale: 1" = 400'

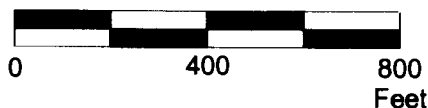

This map was prepared for the purpose of identifying the location of a water right only and is not intended to provide legal dimensions or location of property ownership lines.

Claim of Beneficial Use Map
Application S-87226, Permit S-54630

Robert Rissberger
T.23S. R.6E. Section 14, W.M., Tract G-1, Lot 9

08/2011

Pacific Hydro-Geology Inc.