


# T19S, R43E, Sections 10 and 11, Willamette Meridian

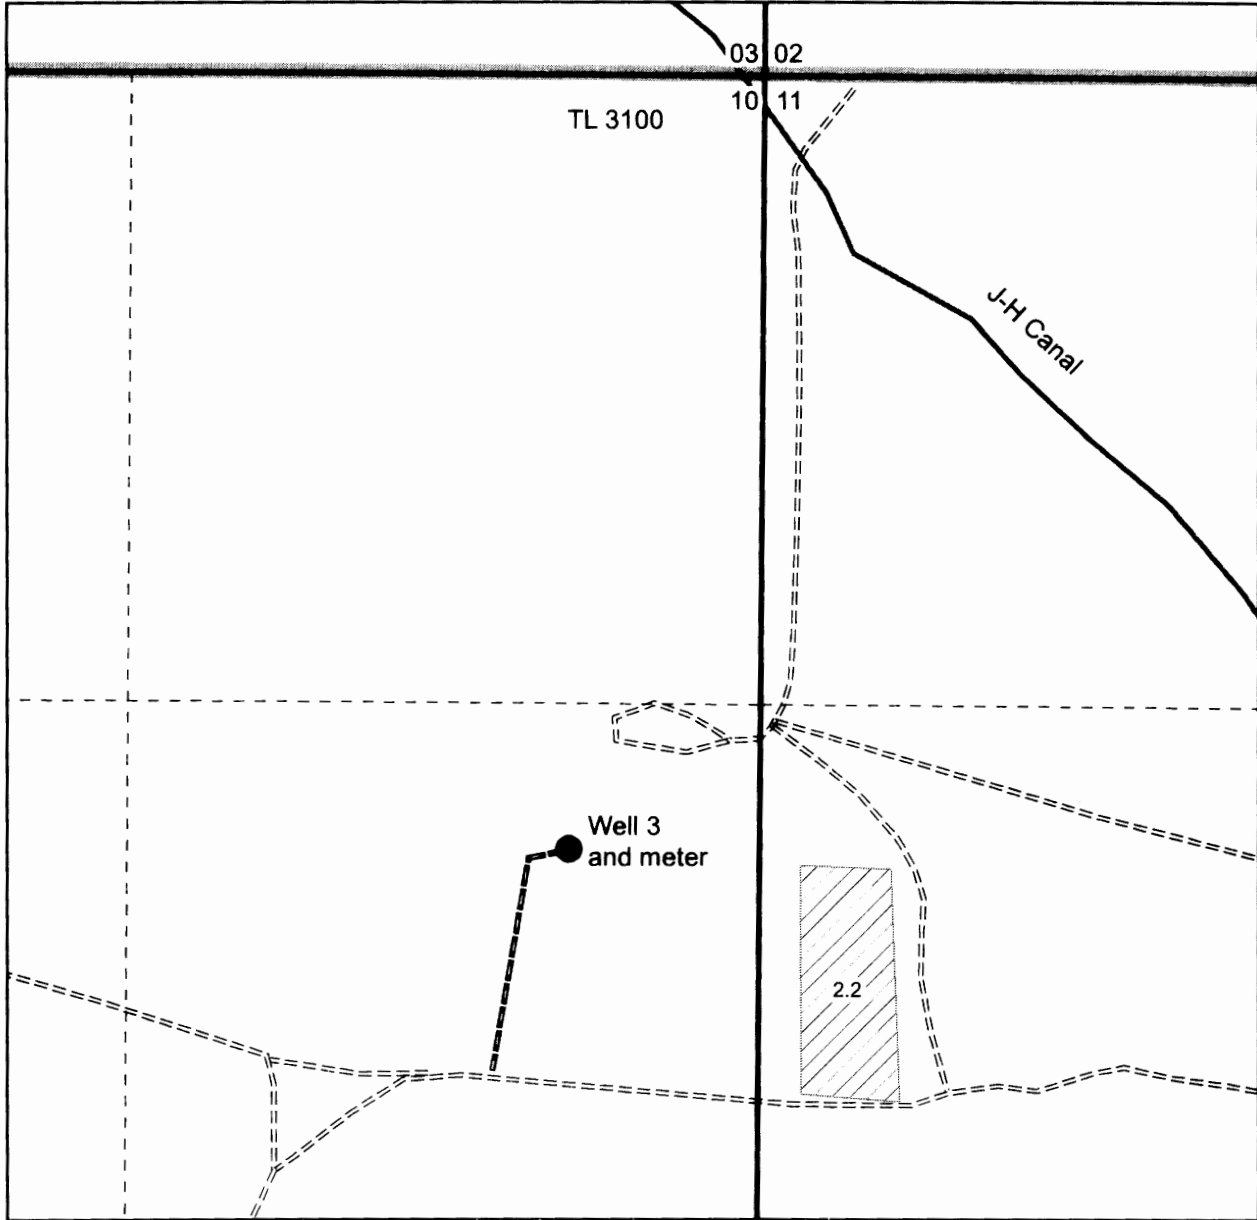


- Well
- Buried 4" PVC pipe
- Canal
- ==== Dirt Road
- - - Quarter quarter line
- Section line
- ▨ Tax lot lines
- ▨ Permit G17296



*Expires 12/31/2010*

Well 3 (MAHL 53140, L85131) is located 415 feet west and 1,615 feet south of the NE corner of Section 10.

This map is not intended to provide legal dimensions or locations of property ownership lines.

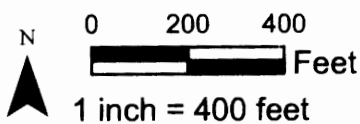

Final Proof Map  
Permit G17296 and Application G17811  
Tax lot 3100

Map prepared for Jerry Baker

Nancy Rorick Consulting