




T.18S. R.8E. Section 32, W.M.

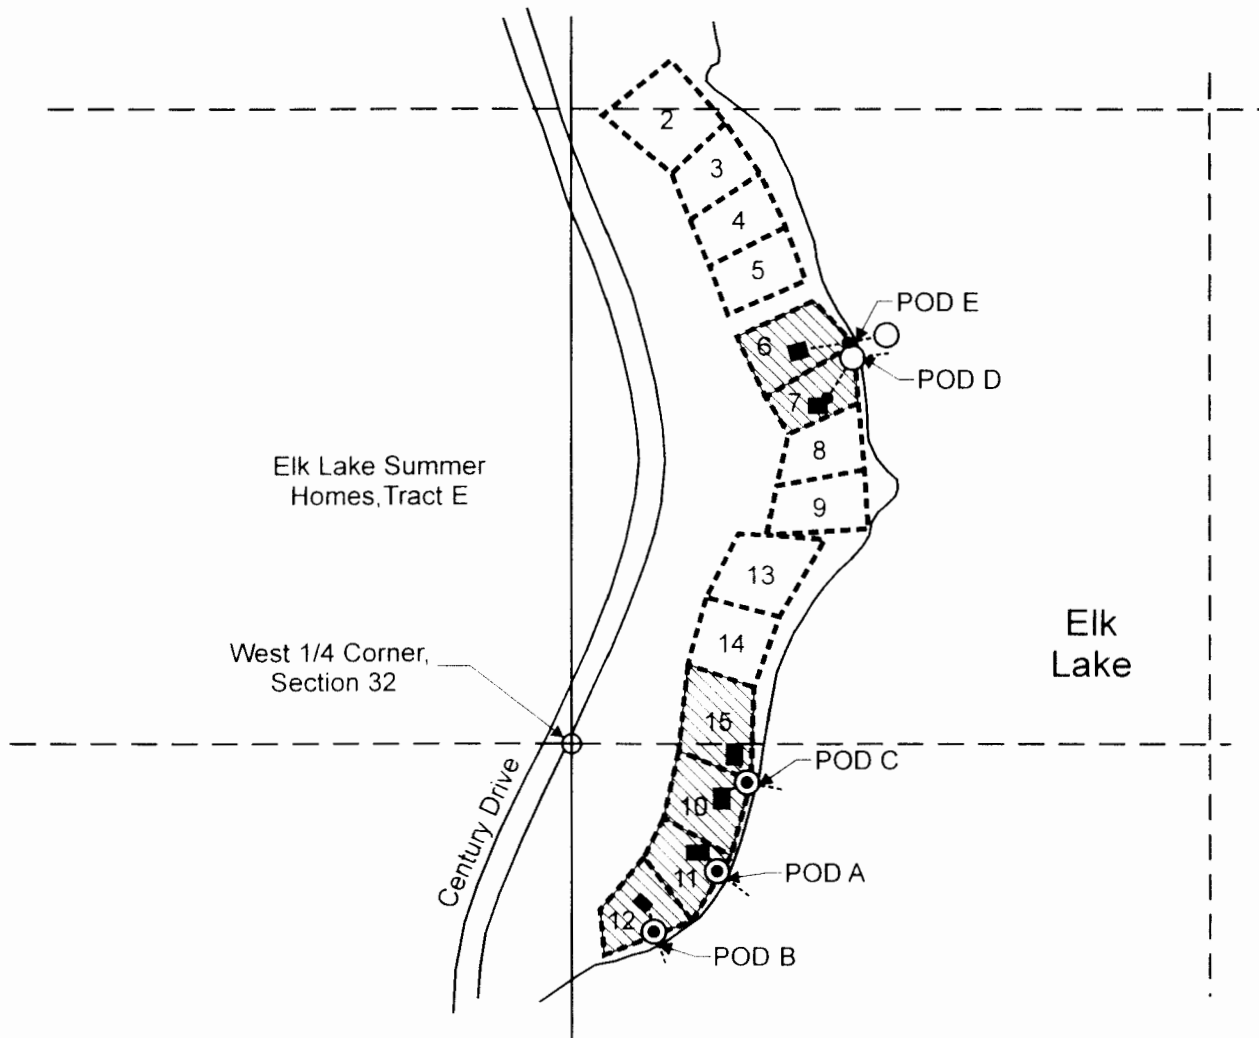

POD A is located 280 feet south and 320 feet east from the W1/4 corner, Section 32.
 POD B is located 420 feet south and 180 feet east from the W1/4 corner, Section 32.
 POD C is located 80 feet south and 380 feet east from the W1/4 corner, Section 32.
 POD D is located 810 feet north and 600 feet east from the W1/4 corner, Section 32.
 POD E is located 840 feet north and 590 feet east from the W1/4 corner, Section 32.

- Area of use for Human Consumption.
- Tax lot boundary
- Cabin Location
- Pump Location
- Meter Location
- Mainline

Scale: 1" = 400'

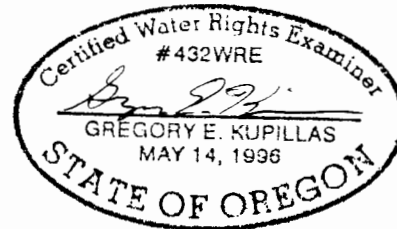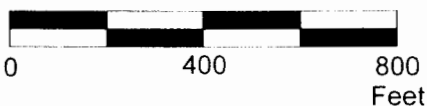

EXPIRATION DATE: 6/30/2013

This map was prepared for the purpose of identifying the location of a water right only and is not intended to provide legal dimensions or location of property ownership lines.

Claim of Beneficial Use Map
 Application S-86965, Permit S-54608

Elk Lake Track E - Group Permit
 T.18S. R.8E. Section 32, W.M.

Pacific Hydro-Geology Inc.

11/2011