


T.2S., R.2W., W.M.

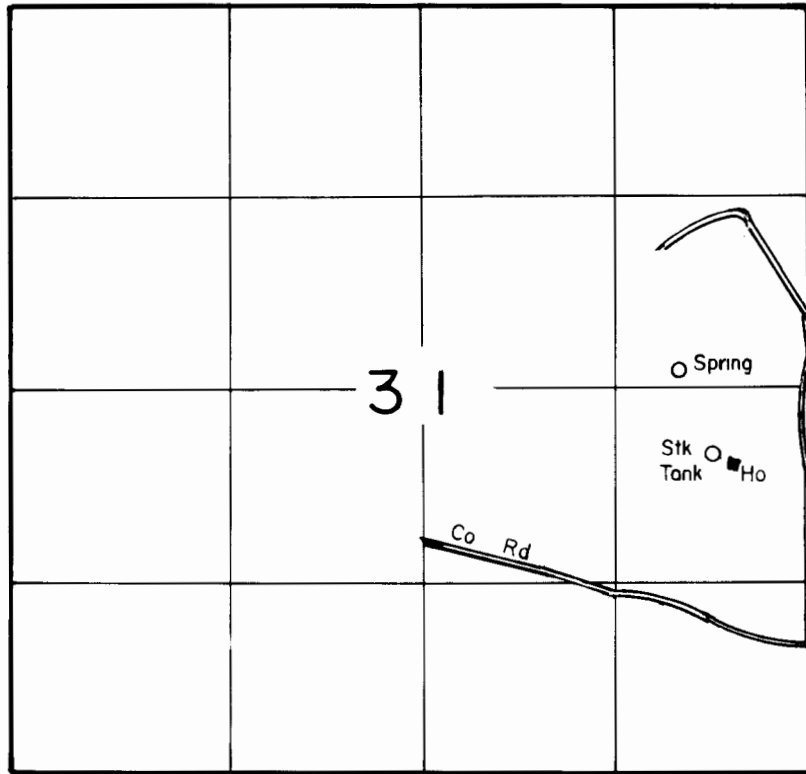

Spring Loc 150' N & 860' W From The E 1/4 Corner Of Section 31

SCALE: 1" = 1320'

FINAL PROOF SURVEY
UNDER

TRANSFER NO 4035

Application No. Permit No.
IN NAME OF

..... **CRAIG** **ROYER**

Surveyed APRIL 17... 1989., by T.M. WARREN.....