

APPLICATION MAP FOR A CLAIM OF BENEFICIAL USE  
APPLICATION FILE NUMBER: S-74924

RECEIVED

MAY 09 2012

WATER RESOURCES DEPT  
SALEM, OREGON

IN THE NAME OF: OLLIE LORENE CASEY  
PROPERTY LOCATED IN THE SW 1/4 OF SECTION 23  
TOWNSHIP 25 SOUTH, RANGE 12 WEST W.M. TAX LOT 401  
TAX MAP REFERENCE NUMBER: 25-12-13-C

APPLICANT:  
OLLIE LORENE CASEY  
HC 52 BOX 426  
COOS BAY, OR 97420

PREPARED BY:  
SHANNON SOUZA, CWRE  
SOL COAST CONSULTING  
& DESIGN, LLC.  
65431 MILLICOMA RD.  
COOS BAY, OREGON 97420

UNKNOWN TRIBUTARY

P.O.D.

CONVEYANCE  
SYSTEM

H2O  
TANKS

HOUSE

SHED

T.L.  
200

T.L.  
300

T.L.401

T.L.400  
25-12-23C

(ENERGREN FERRY ALLEGANY CO. RD.)

STATE HWY 241

POINT OF DIVERSION  
IS 1099 FEET NORTH  
AND 275 FEET EAST OF  
THE SECTION COR.  
COMMON TO SECTIONS  
22,23,26 AND 27


LEGEND:



FOUND PLSS CORNER




POINT OF DIVERSION

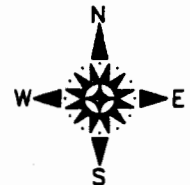

200' 100' 0 100' 200'

1" = 200' - 0"

22 23  
27 26

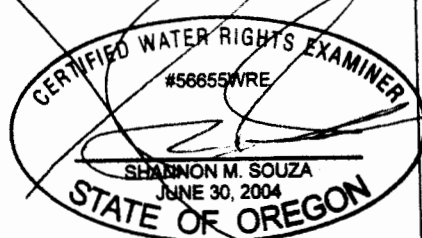

EXPIRATION DATE: 6/2012

THE PURPOSE OF THIS MAP IS TO  
IDENTIFY THE LOCATION OF THE WATER  
RIGHT. THIS MAP IS NOT INTENDED TO  
PROVIDE LEGAL DIMENSIONS OR  
LOCATIONS OF PROPERTY OWNERSHIP  
LINES

MILLICOMA RIVER  
(TIDAL LANDS)