



3  
**T.20S., R.5W., W.M.**  
**SE1/4, SECTION 9**

THE PURPOSE OF THIS MAP IS TO IDENTIFY THE LOCATION OF THE WATER RIGHT. IT IS NOT INTENDED TO PROVIDE INFORMATION RELATIVE TO THE LOCATION OF PROPERTY OWNERSHIP BOUNDARY LINES.


**RECEIVED**

JUN - 9 2003

WATER RESOURCES DEPT  
SALEM, OREGON

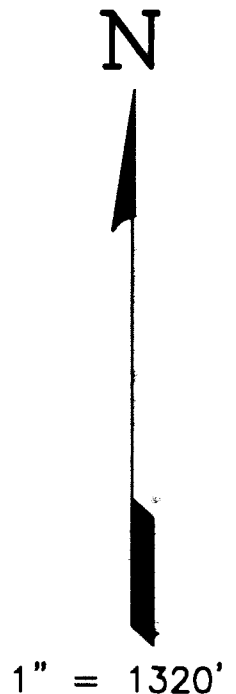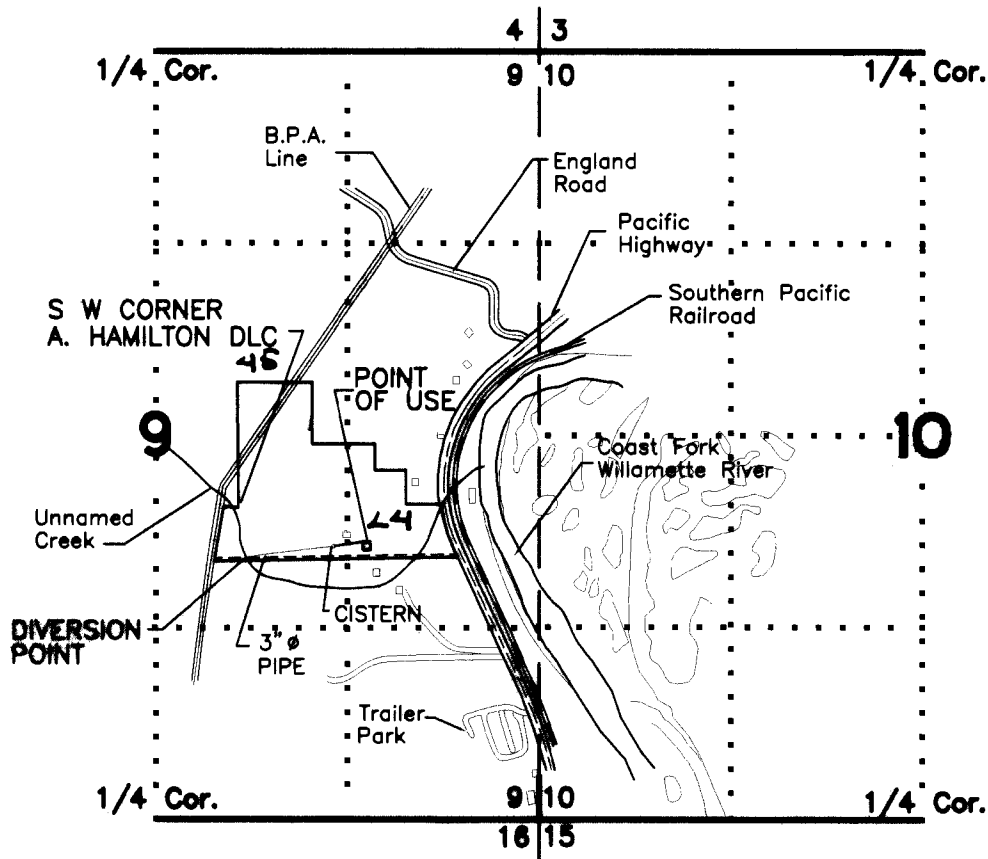

THE DIVERSION POINT IS LOCATED <sup>375</sup> ~~250'~~ SOUTH AND <sup>65 EAST</sup> ~~200'~~ WEST  
OF THE N.E. CORNER OF SECTION 10.  
<sup>SW</sup> ~~HAMILTON DLC 45~~

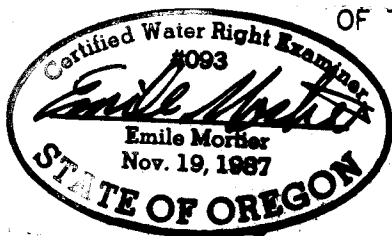

6/3/03

**FINAL PROOF SURVEY**

UNDER

Application No. S-83877 Permit No. 53553

IN THE NAME OF

**WILLIAM E. HENDERSON**

Surveyed ...MAY.3..... 2003.. by JON.HARTWELL..

Map revisions by Dept include Range to 3W, POD measured dis.,  
Glot 4 & DLC 45. mfb/wrd 1-12-17