


T.23S. R.6E. Section 14, W.M.

(Section and 16th Lines are Unsurveyed and Shown Only in Approximate Locations)

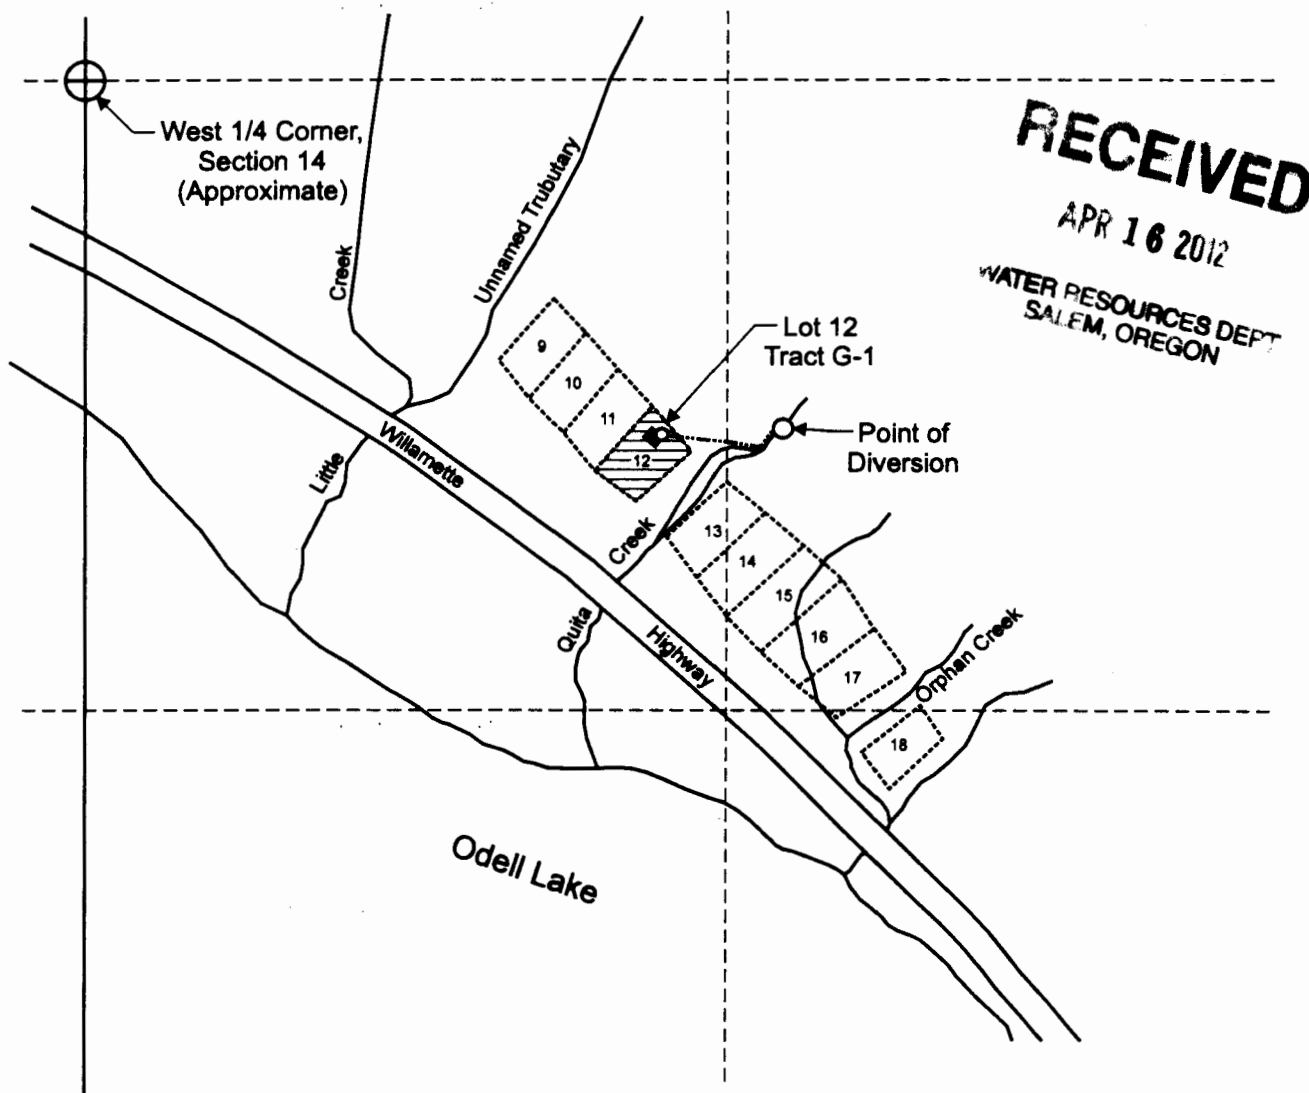

Point of diversion is located 50 feet south and 270 feet east from the most northerly corner, Lot 12, Tract G-1.

Area of use for Human Consumption



----- Tax lot boundary

■ Cabin Location

○ Meter Location

----- Mainline

Scale: 1" = 400'

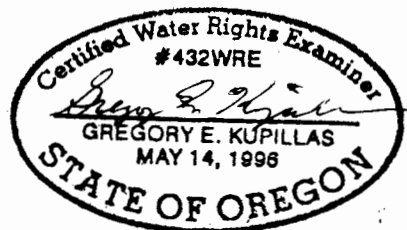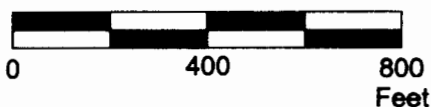

EXPIRATION DATE: 6/30/2013

This map was prepared for the purpose of identifying the location of a water right only and is not intended to provide legal dimensions or location of property ownership lines.

Claim of Beneficial Use Map
Application S-87302, Permit S-54636

Timothy and Sandra Godsil
T.23S. R.6E. Section 14, W.M., Tract G-1, Lot 12

Pacific Hydro-Geology Inc.

08/2011