



T.18S. R.8E. Section 32, W.M.

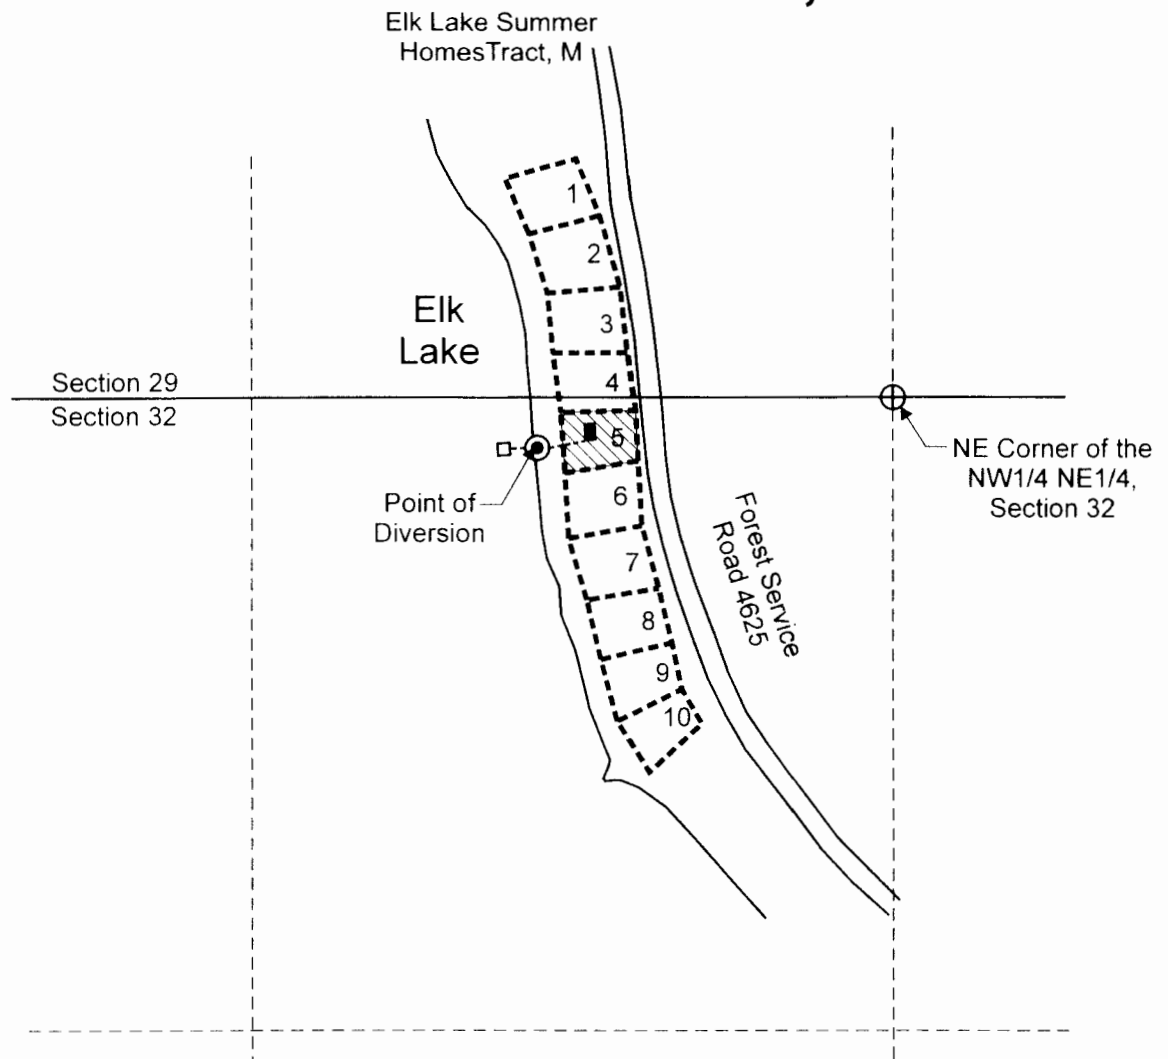

Point of Diversion is located 110 feet south and 740 feet west from NE corner of the NW1/4 NE1/4, Section 32.
 Note: Pump location on the shore is subject to change depending on lake level.

-  Location of use for Human Consumption.
-  Tax lot boundary
-  Pump location
-  Meter location
-  Fish screen location
-  Mainline

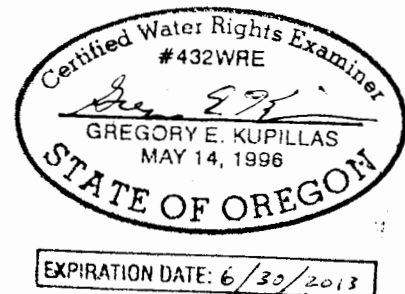

Scale: 1" = 400'



This map was prepared for the purpose of identifying the location of a water right only and is not intended to provide legal dimensions or location of property ownership lines.

Claim of Beneficial Use Map
 Application S-86904, Permit S-54658

Elk Lake Tract M - Joan Pease
 T.18S. R.8E. Section 32, Lot 5 W.M.

Pacific Hydro-Geology Inc.

11/2011