


NE SEC 26 + NW SEC 25

WATER RIGHT CLAIM OF BENEFICIAL USE MAP
FOR
CHARLES & MARGARET HAMLIN
LOCATED IN THE
NW 1/4 OF SECTION 25, NE 1/4 SECTION 26
TOWNSHIP 19 SOUTH, RANGE 12 WEST, W.M.,
TAX LOT 401,
LANE COUNTY OREGON,
JANUARY 10, 2012
APP # S-85650, PERMIT # S-54057

TL 401 = 0.33AC.

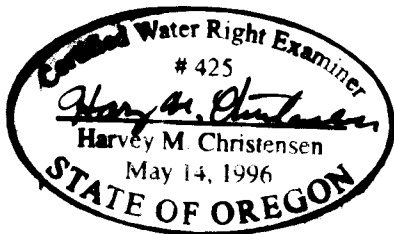

SILTCOOS LAKE


POD #1 & FISH SCREEN

219' SOUTH
160' WEST
OF THE NW
OF SECTION 25




SUCTION PIPE LINE

DOCK

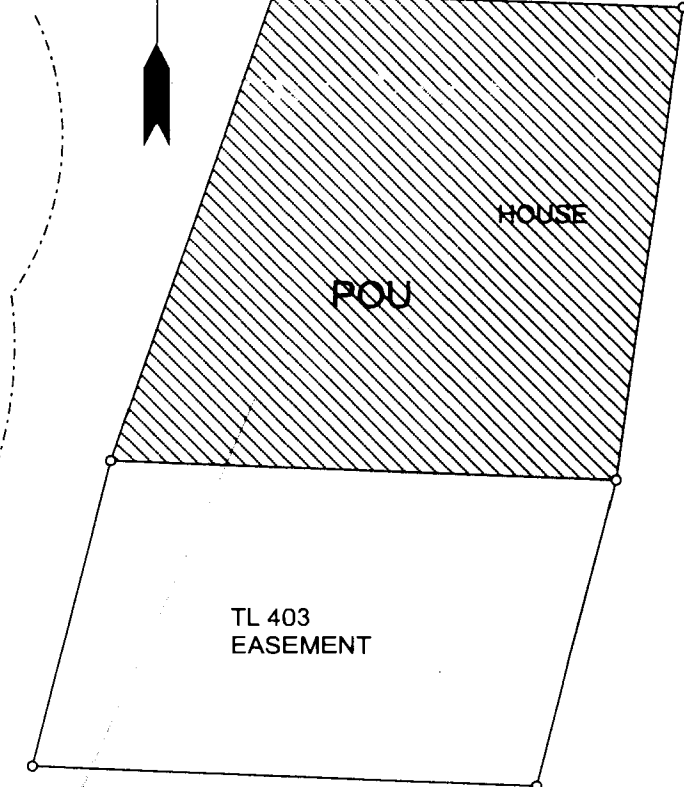

PUMP HOUSE
& METER,
TL 402

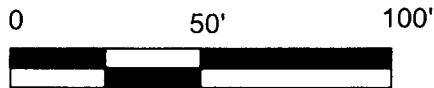

LEGEND	
+	SECTION CORNER
☒	POD #1
○	PROPERTY CORNER

DISCLAIMER: THIS MAP IS NOT TO BE
USED FOR PROPERTY LOCATION. IT
IS FOR WATER RIGHT PURPOSES ONLY.

RECIVED

FEB 2 2012

WATER RESOURCES DEPT
SALEM, OREGON