



T.18S. R.8E. Section 29, W.M.

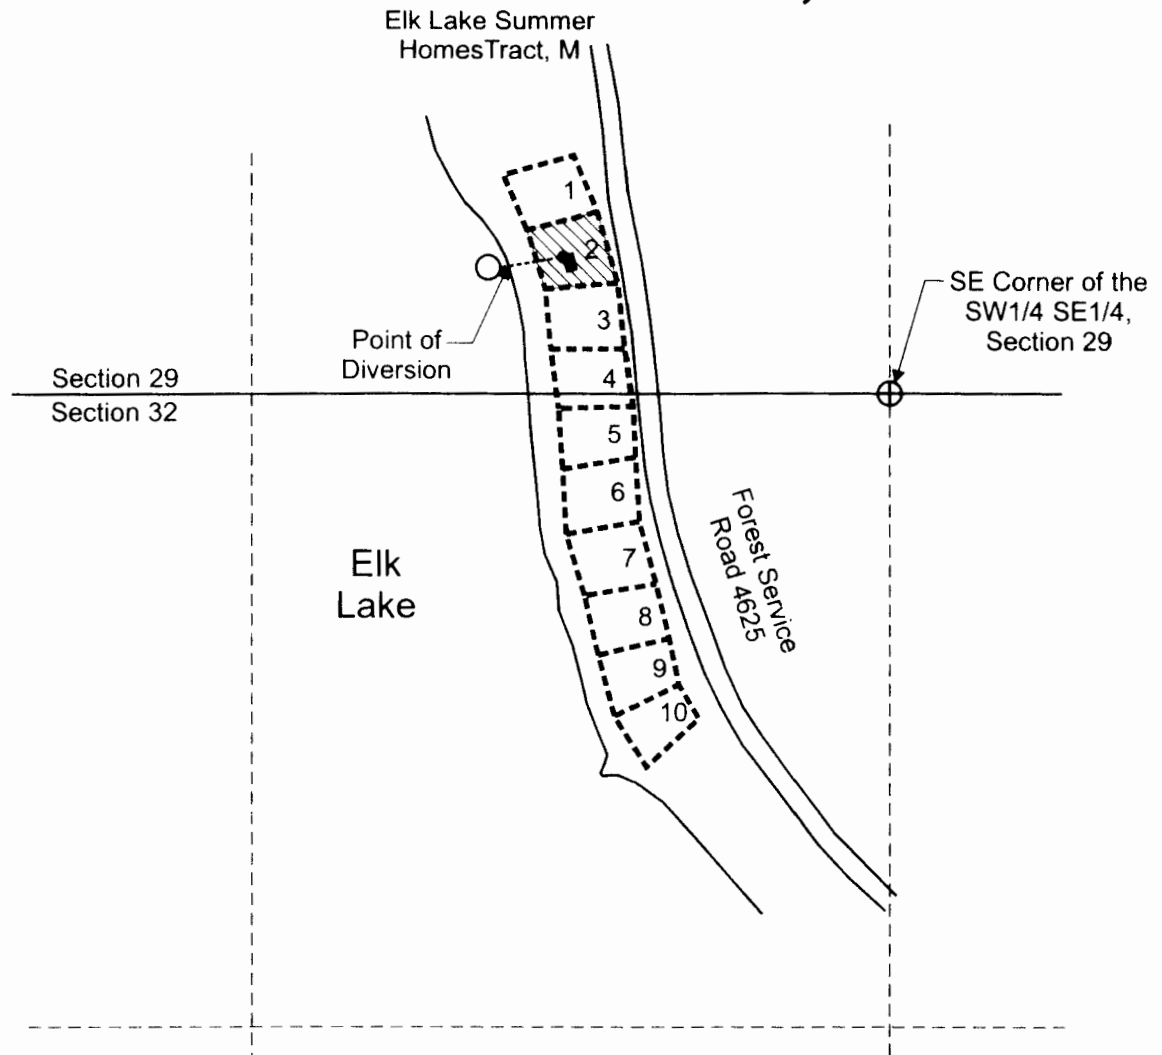


Point of Diversion is located 260 feet north and 790 feet west from SE corner of the SW1/4 SE1/4, Section 29.
 Note: Point of Diversion location subject to minor changes depending on lake levels.

- Location of use for human consumption.
- Tax lot boundary
- Pump location
- Meter location
- Mainline

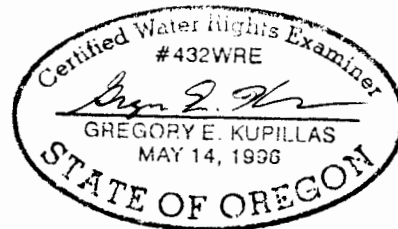

EXPIRATION DATE: 6/30/2013

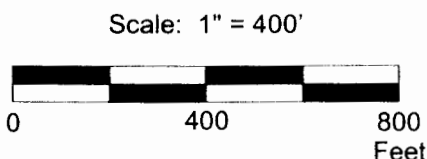

This map was prepared for the purpose of identifying the location of a water right only and is not intended to provide legal dimensions or location of property ownership lines.

Claim of Beneficial Use Map
 Application S-86909, Permit S-54670

Elk Lake Tract M - David and Rebecca Weber
 T.18S. R.8E. Section 29, W.M.

Pacific Hydro-Geology Inc.

11/2011