




T.18S. R.8E. Section 32, W.M.

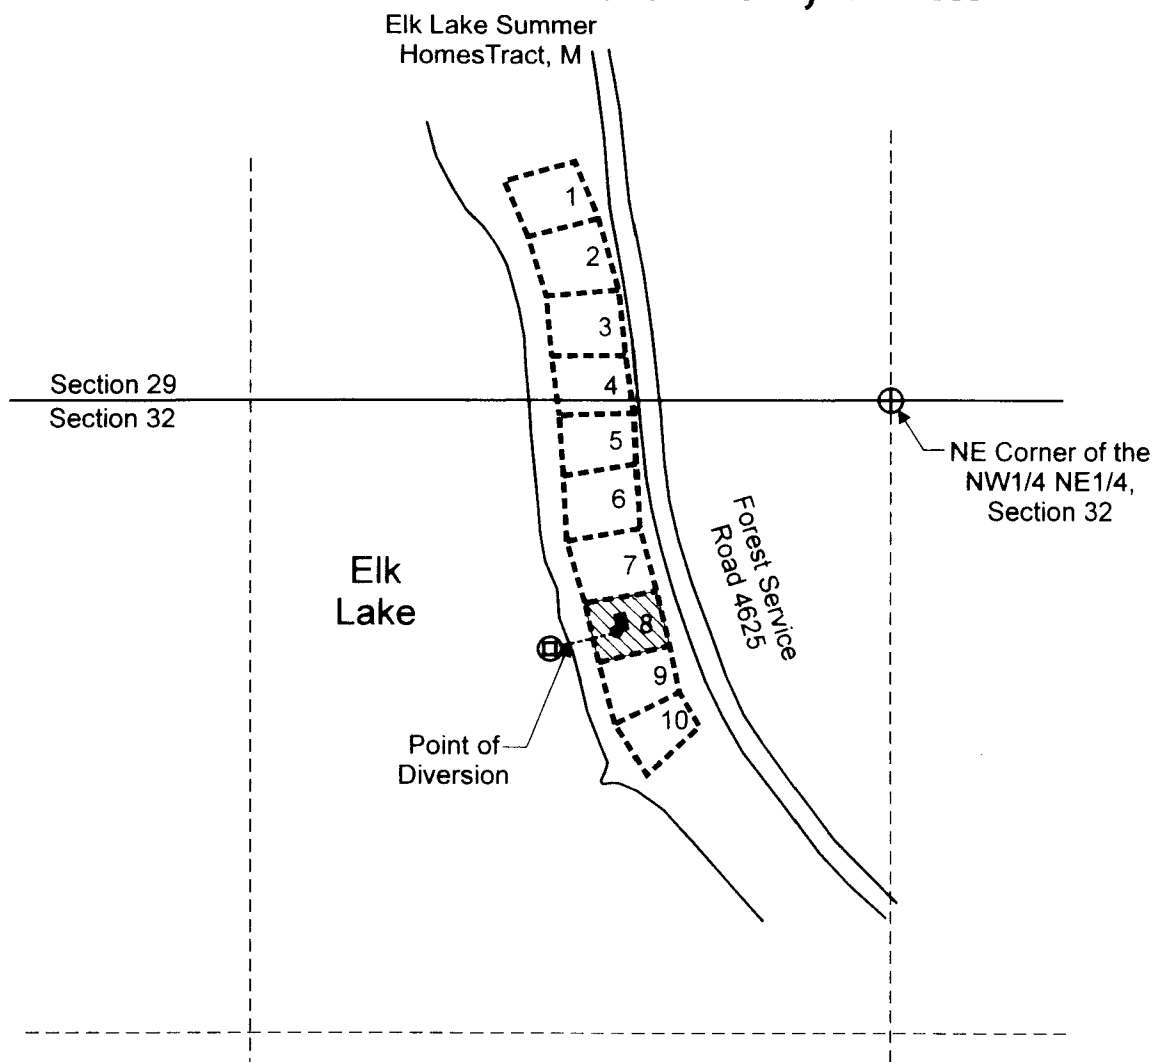

Point of Diversion is located 510 feet south and 670 feet west from NE corner of the NW1/4 NE1/4, Section 32.

- Location of use for Human Consumption.
- Tax lot boundary
- Pump location
- Meter location
- Fish screen location
- Mainline

Scale: 1" = 400'

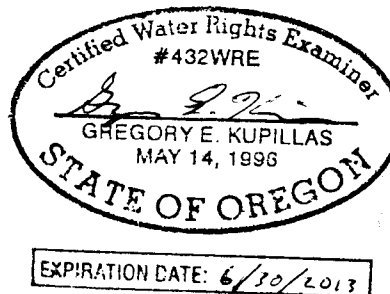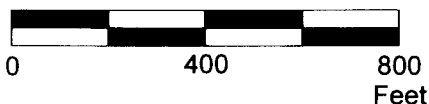

This map was prepared for the purpose of identifying the location of a water right only and is not intended to provide legal dimensions or location of property ownership lines.

Claim of Beneficial Use Map
Application S-86850, Permit S-54640

Elk Lake Tract M - L. Scott Letourneau
T.18S. R.8E. Section 32, W.M.

Pacific Hydro-Geology Inc.

11/2011