


T.18S. R.8E. Section 32, W.M.

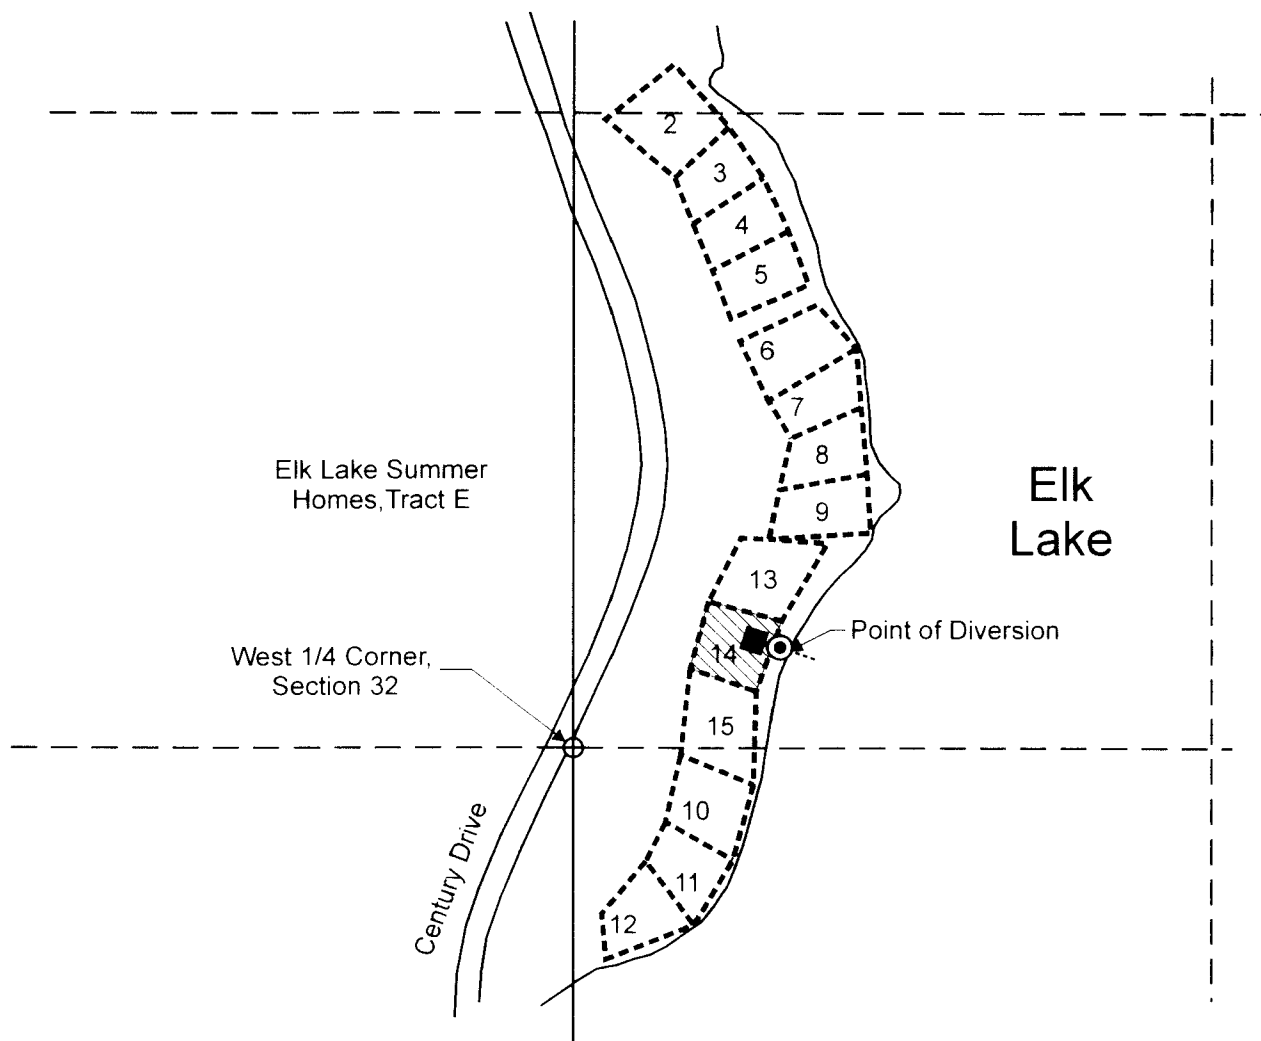

Point of Diversion is located 200 feet north and 450 feet east from the W1/4 corner, Section 32.


Location of use for Human Consumption.

----- Tax lot boundary

○ Pump Location


● Pump Location

----- Mainline

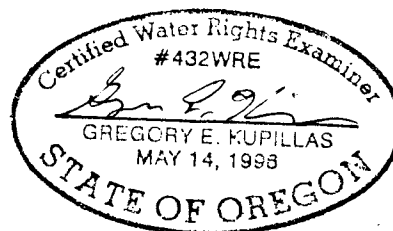

EXPIRATION DATE: 6/30/2013

Scale: 1" = 400'

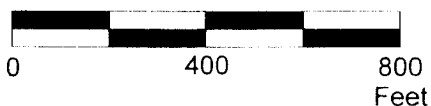

This map was prepared for the purpose of identifying the location of a water right only and is not intended to provide legal dimensions or location of property ownership lines.

Claim of Beneficial Use Map
Application S-86882, Permit S-54609

Elk Lake Track E - Marilyn McIver
T.18S. R.8E. Section 32, W.M.

Pacific Hydro-Geology Inc.

07/2011