




T. 4 S., R. 1 E., W.M.

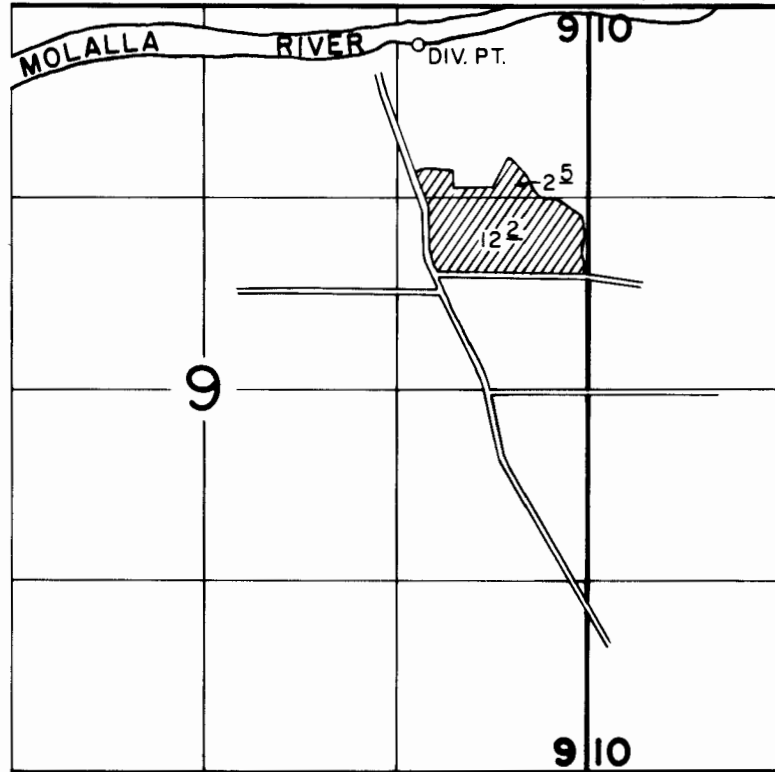

DIV. PT. LOC: 260' S. & 1170' W. FROM THE NE CORNER SECTION 9

SCALE: 1" = 1320'

FINAL PROOF SURVEY UNDER

Application No. 63718... Permit No. 46886.....
IN NAME OF

.....**ANDREW M. HEIN**.....

Surveyed **JULY 9, 1985**, by **J. WARREN**.....