



1" = 400'

NOTE: THIS MAP IS NOT INTENDED TO PROVIDE LEGAL
DIMENSIONS OR LOCATIONS OF PROPERTY OWNERSHIP LINES.

DESCHUTES COUNTY, OREGON

**TOWNSHIP 18 SOUTH
RANGE 8 EAST,
WILLAMETTE MERIDIAN**

**SECTION 32 TAX LOT 100A-2
SW 1/4 NW 1/4**



APPLICATION S-86915

PERMIT S-54623

RECEIVED BY OWRD

AUG 16 2012

SALEM, OR

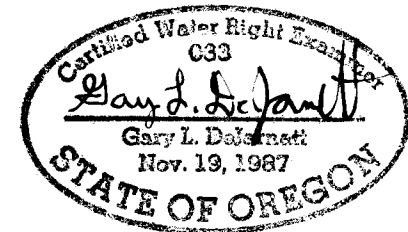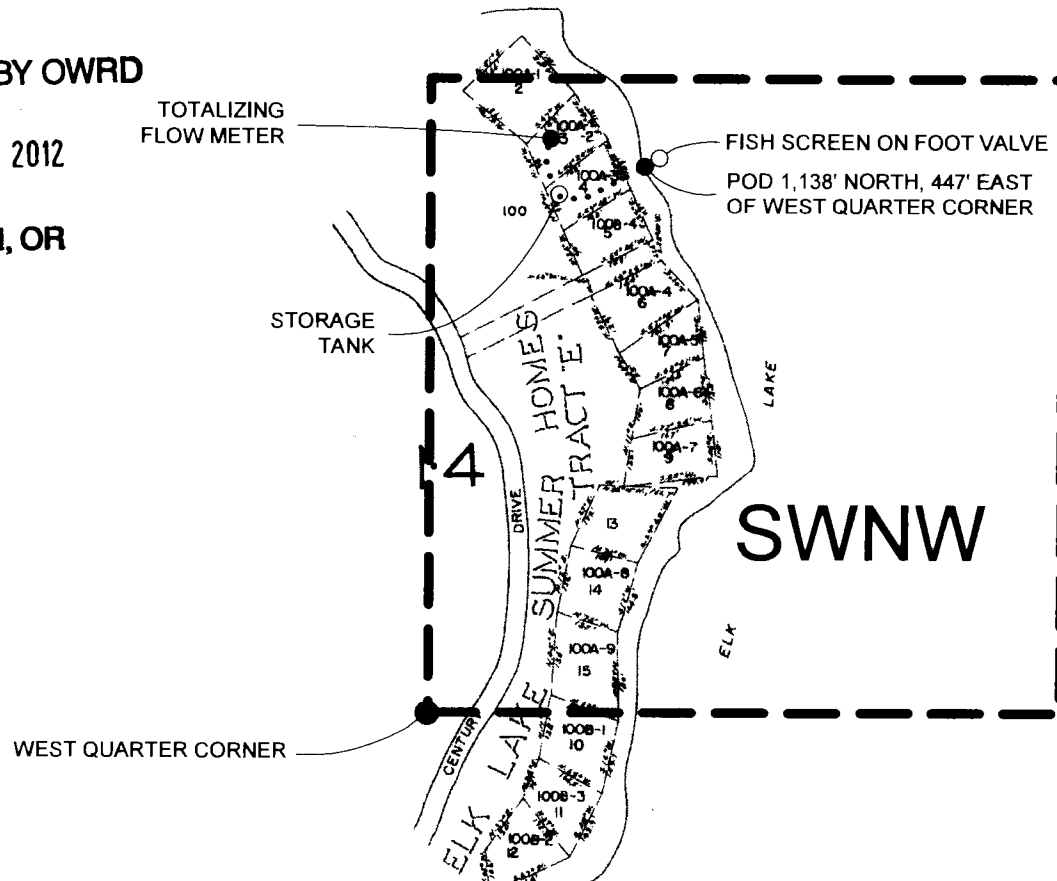

RENEWAL DATE: 12-31-2013



QUARTER QUARTER BOUNDARY



BURIED PIPELINE

TITLE

**CLAIM OF BENEFICIAL USE MAP for
LAURA GOETZ AND USDA FOREST SERVICE**

WATER RIGHT SERVICES, LLC

P.O. BOX 1830, BEND OR 97709

WWW.OREGONWATER.US

(541) 389-2837 CCB# 197121

DATE

JULY 18, 2012

JOHNSHORT@USA.COM

SHEET

1 OF 1

JOB#

12038