


Pond 1	is	625'	South	and	240'	West	of	E $\frac{1}{4}$ Cor.	34
Pond 2		870'	South	and	200'	West	of	E $\frac{1}{4}$ Cor	34
Pond 3		925'	South	and	0'	West	of	E $\frac{1}{4}$ Cor	34

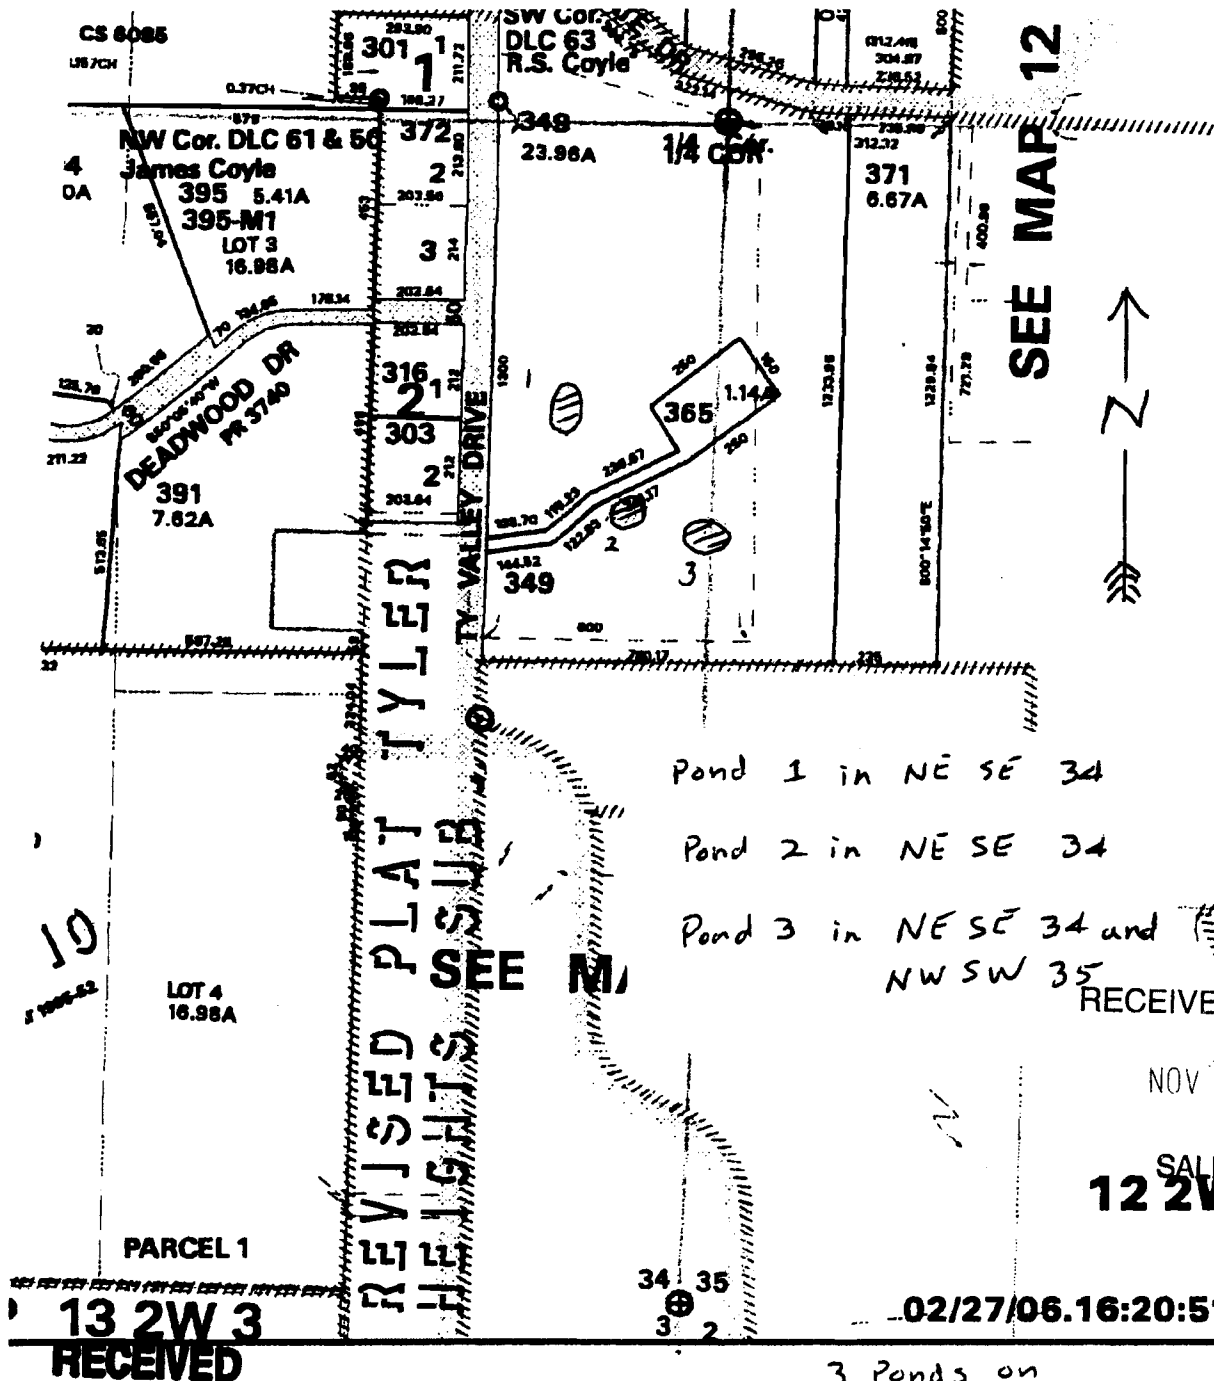


**WATER RESOURCES DEPT
SALEM, OREGON**

App no R 87028

3 Ponds on
Tax lot 349
Tax Map 12 2W 34

Lower Pond #3

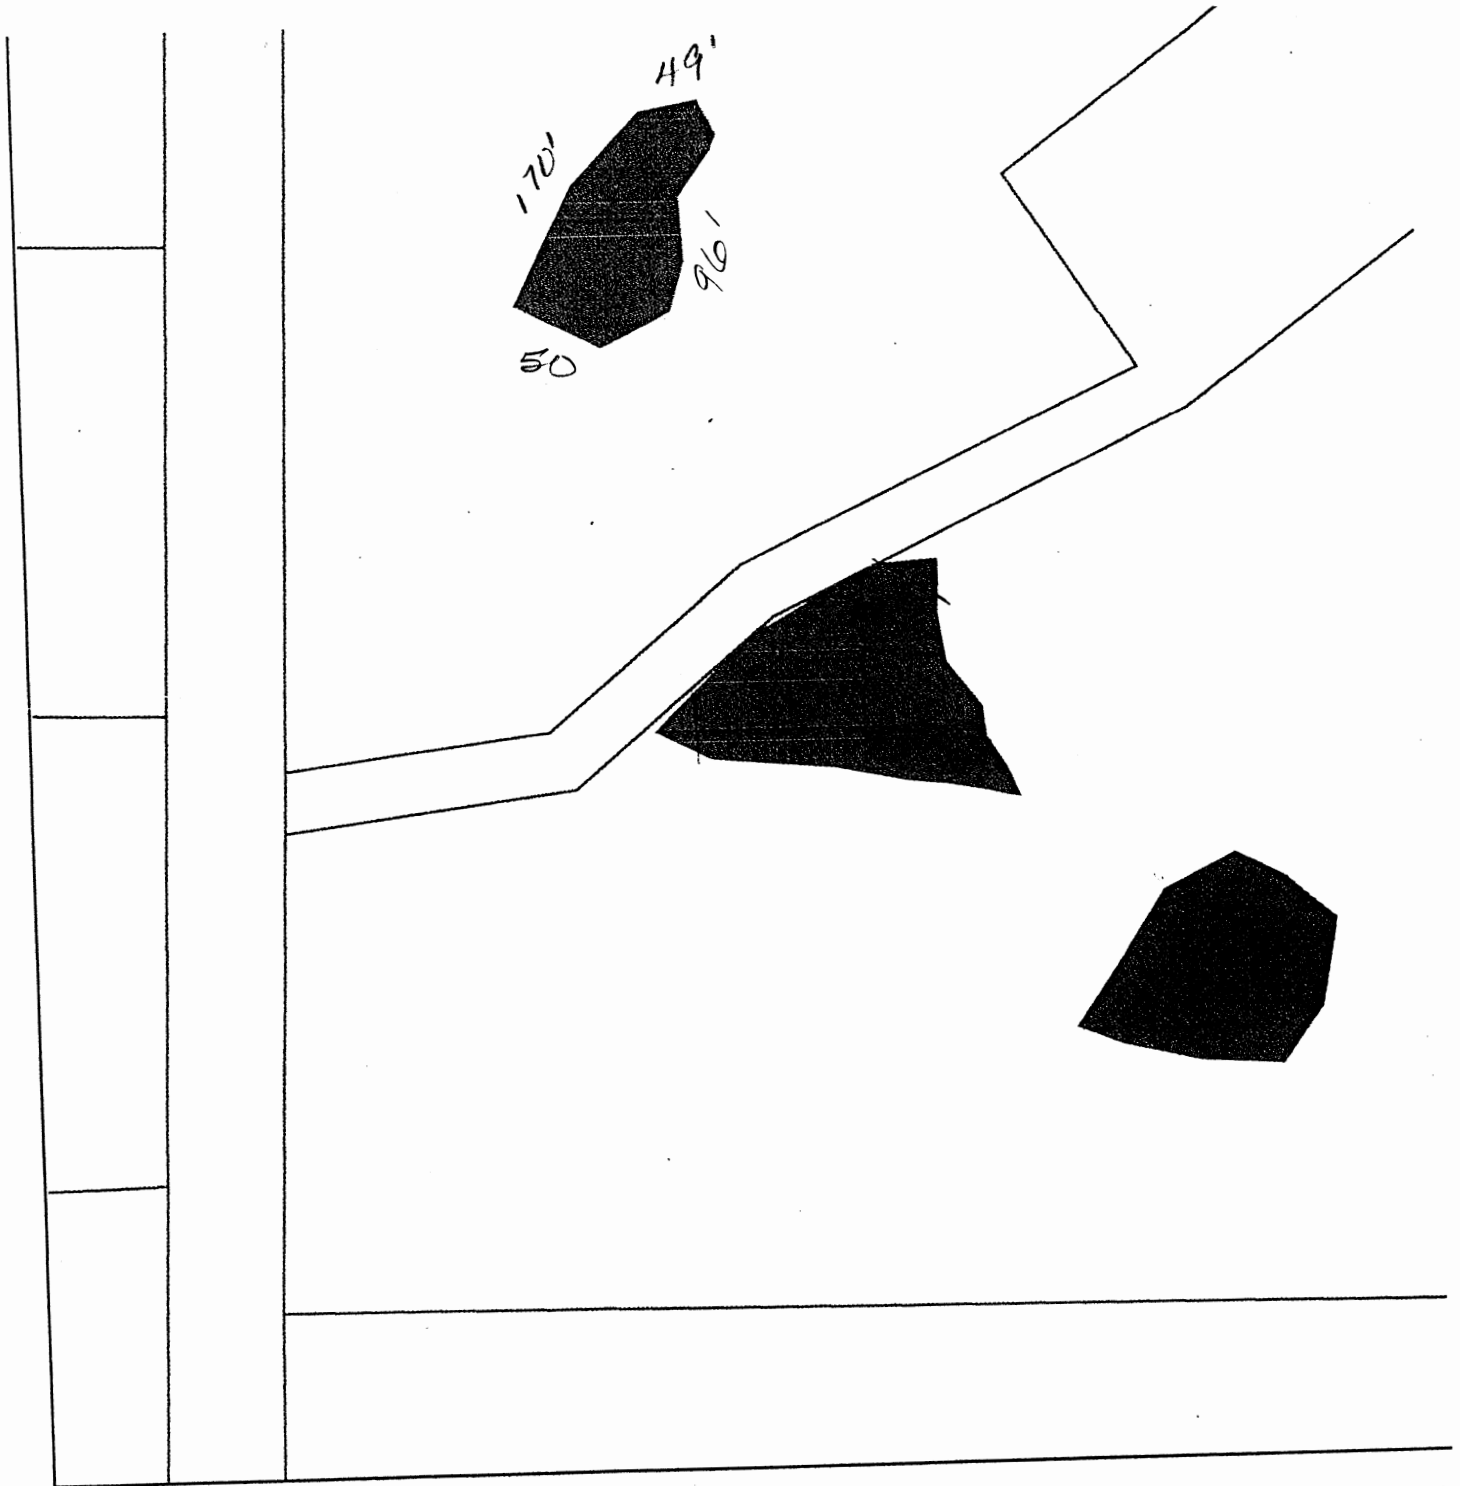

Linn County
GIS Department
P.O. Box 100
Albany, OR 97321



0 50 100 200 Feet

Lin
Thi
or l
shc
use

1 < 100 RECEIVED BY OWRD

copy to 1"

NOV 02 2016

SALEM, OR