


T 12 S , R 2 W Sec 34 & 35

Pond 1 is 625' South and 240' West of E 1/4 Cor. 34
 Pond 2 870' South and 200' West of E 1/4 Cor 34
 Pond 3 925' South and 0' West of E 1/4 Cor 34

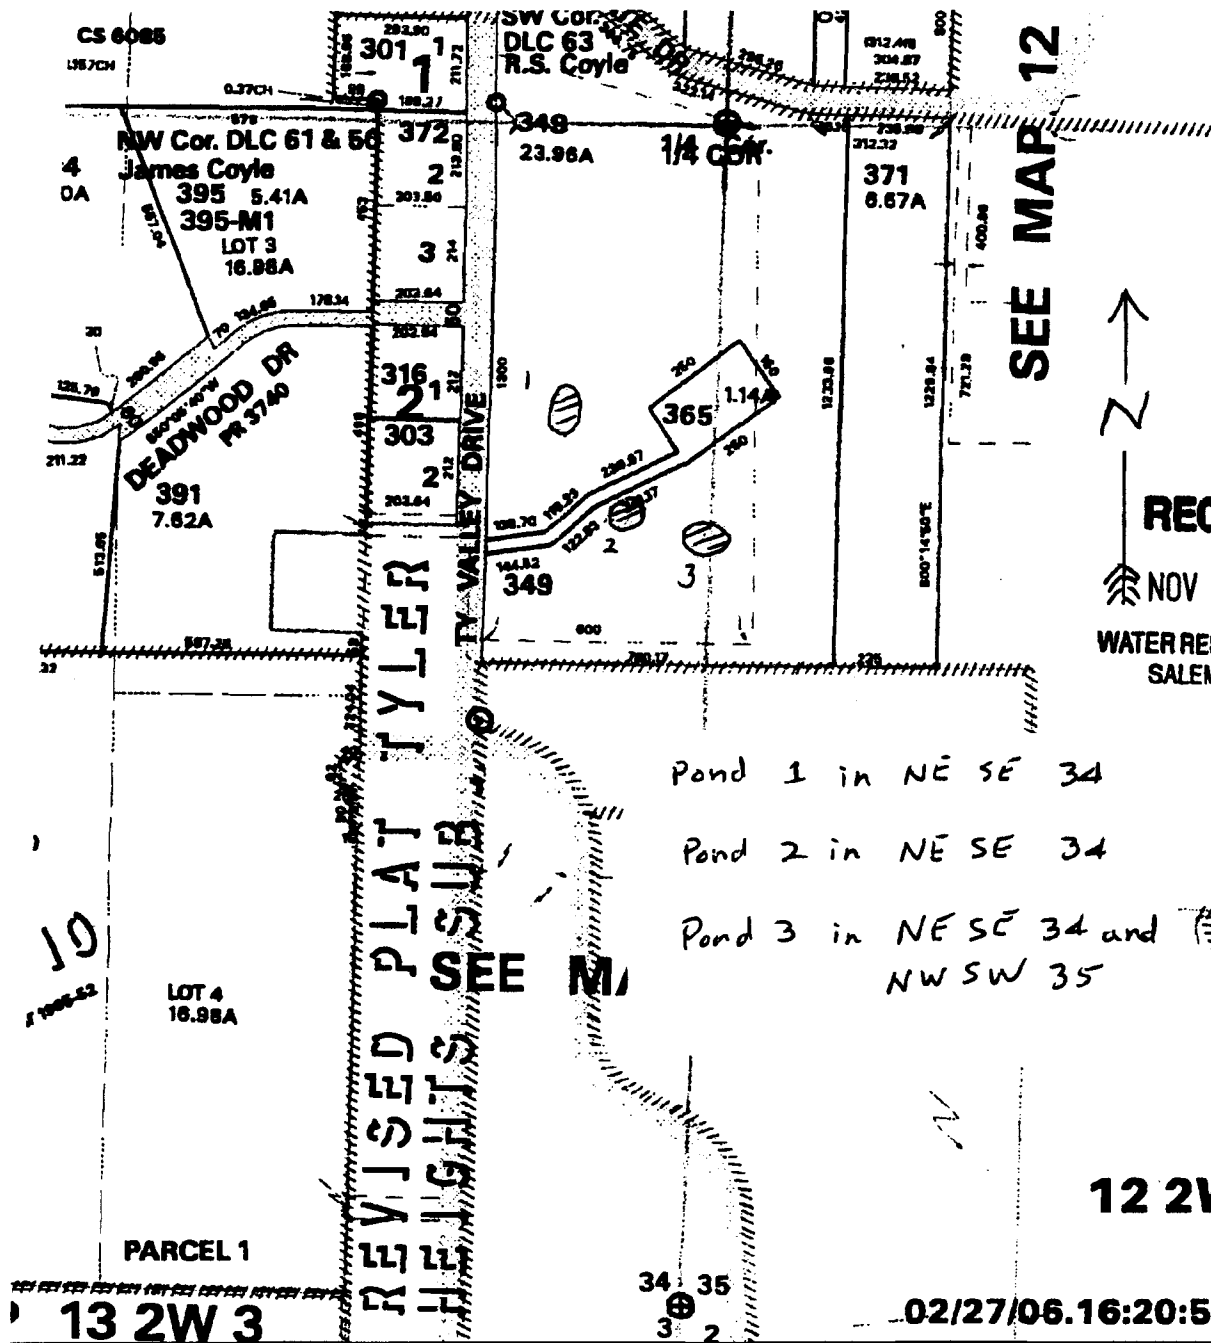

Pond 1 in NE SE 34
 Pond 2 in NE SE 34
 Pond 3 in NE SE 34 and NW SW 35

APPNO R 87026

Scale 1" = 400'

3 Ponds on
 Tax lot 349

Tax Map 12 2W 34

RECEIVED BY OWRD
 NOV 02 2016
 SALEM, OR

Upper Dood # 1



Linn County
GIS Department
P.O. Box 100
Albany, OR 97321



0 50 100 200 Feet

Li
Ti
or
st
us

114

1/100

copy to 1"