


Pond 1	is	625'	South	and	240'	West	of	E $\frac{1}{4}$ Cor.	34
Pond 2		870'	South	and	200'	West	of	E $\frac{1}{4}$ Cor	34
Pond 3		925'	South	and	0'	West	of	E $\frac{1}{4}$ Cor	34

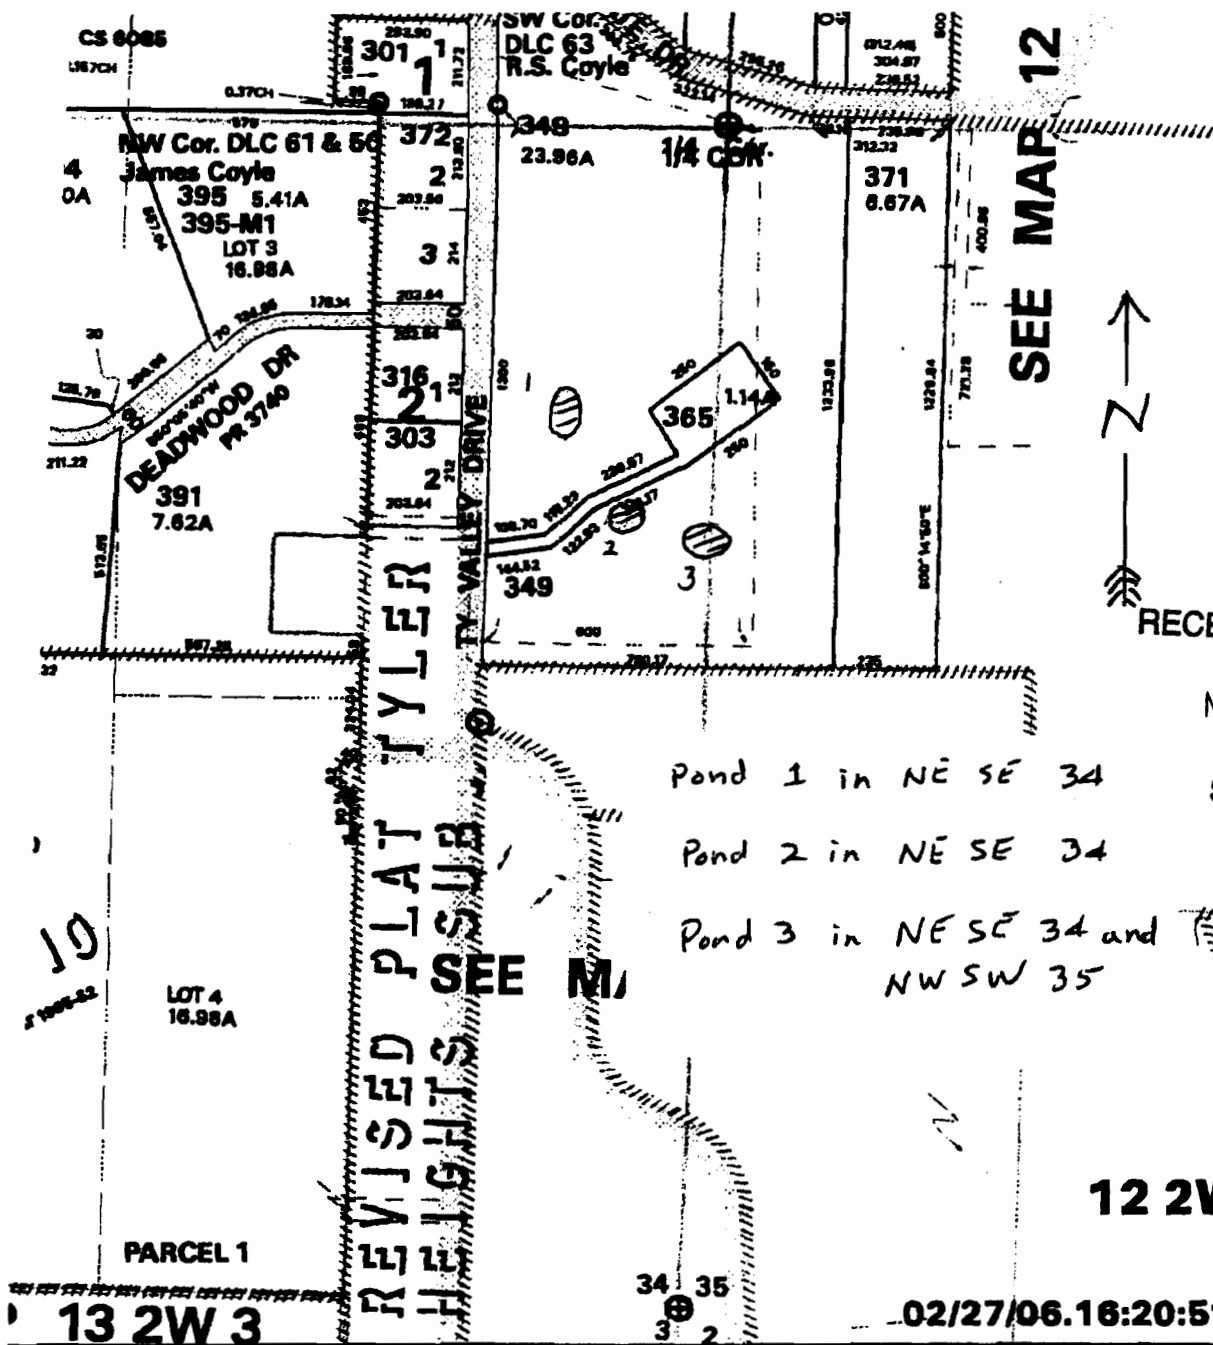

RECEIVED

NOV 08 2007

**WATER RESOURCES DEPT
SALEM, OREGON**

Scale $1" = 400'$

3 Ponds on
Tax lot 349

Tax Map 12 2W 34

Appno R - 87027

Middle Land St



RECEIVED BY OWRD

NOV 02 2016

SALEM, OR



Linn County
GIS Department
P.O. Box 100
Albany, OR 97321



0 50 100 200 Feet

Lin
Thi
or l
shc
use

1/10/17

copy to 1