


CLAIM OF BENEFICIAL USE
 FOR: TIMOTHY AND JILL PRATT
 BY: DUANE W. KIRBY
 T26S, R4W, S18, W.M.
 APPLICATION NO. S-86741
 PERMIT NO. S-54412
 TAX LOT 600
 SCALE: 1" = 400'

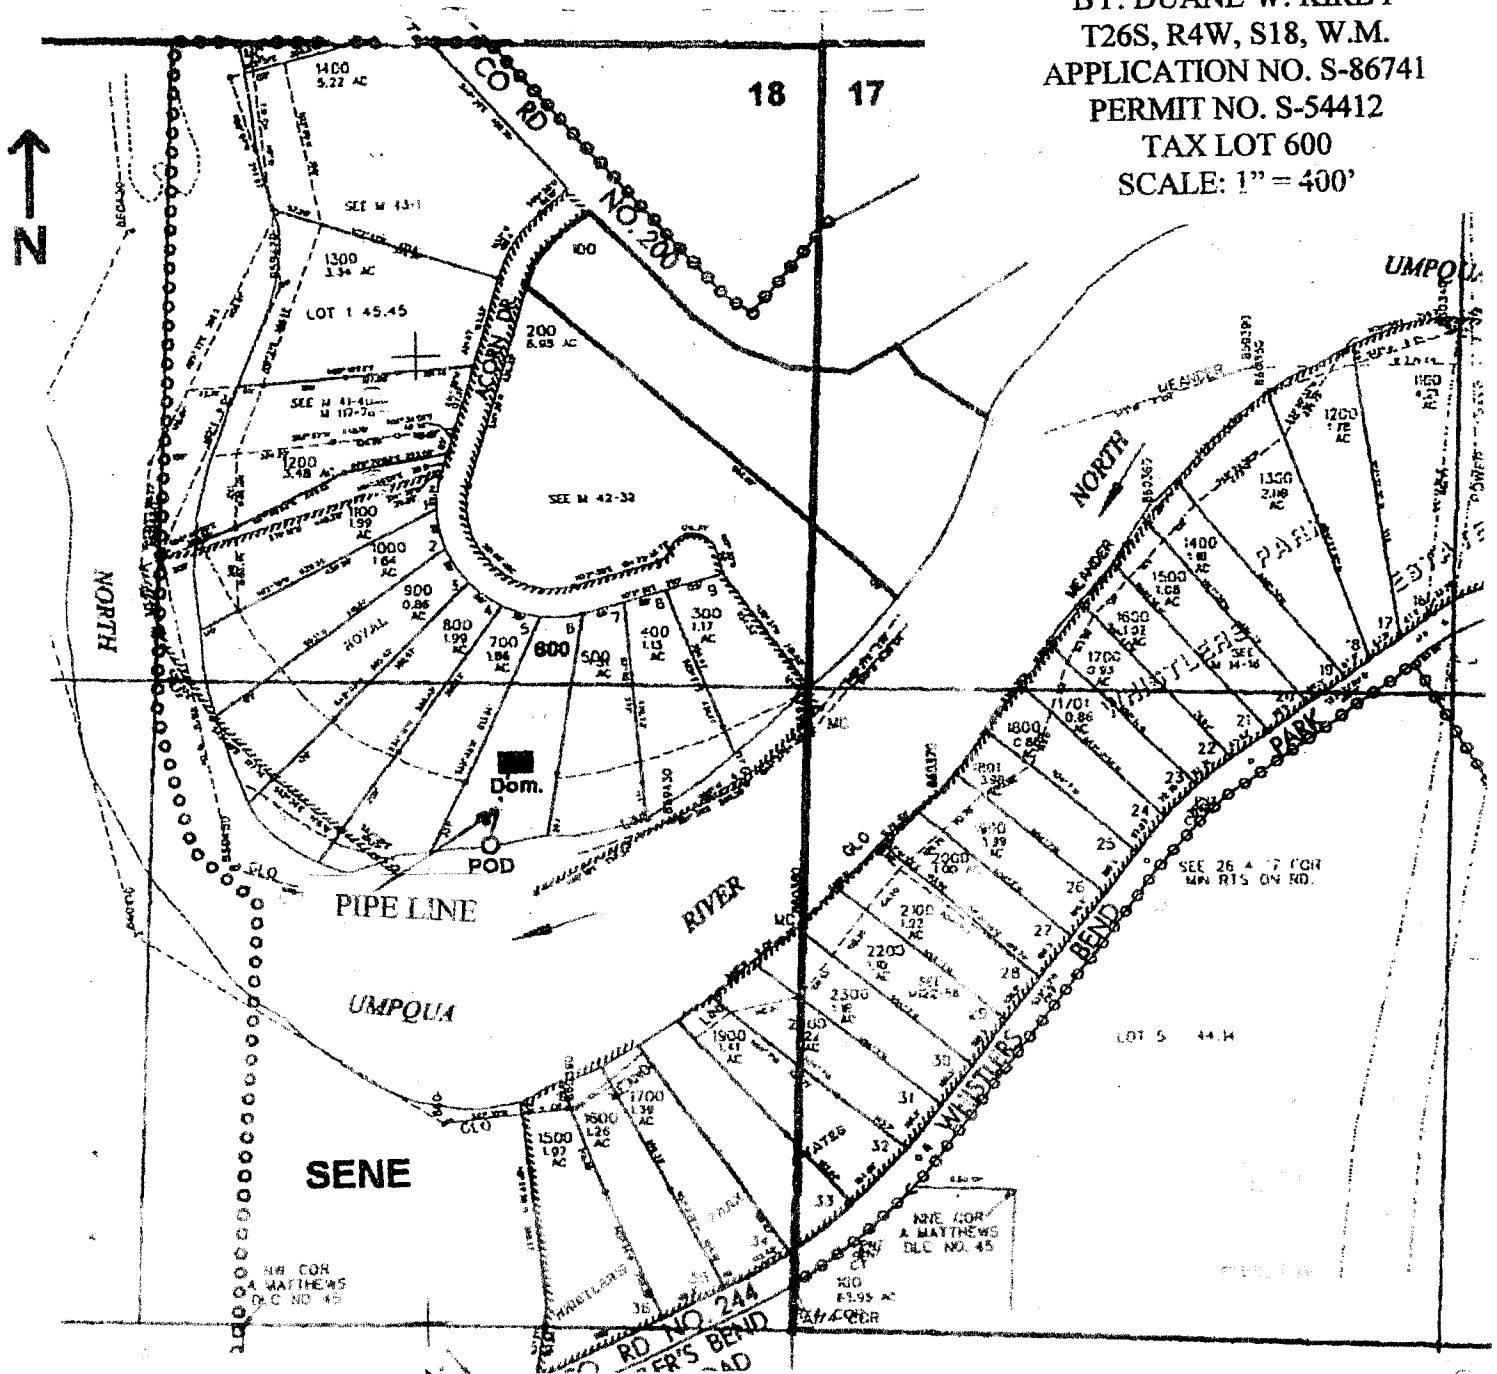

POD is located 1800 ft. S. and 680 ft. W. from the NE corner of Sec. 18

THE PURPOSE OF THIS MAP IS TO IDENTIFY THE LOCATION OF THE WATER RIGHT. IT IS NOT INTENDED TO PROVIDE INFORMATION RELATIVE TO THE LOCATION OF PROPERTY OWNERSHIP BOUNDARY LINES.

