


T. 38 S., R. 26 E., W.M.

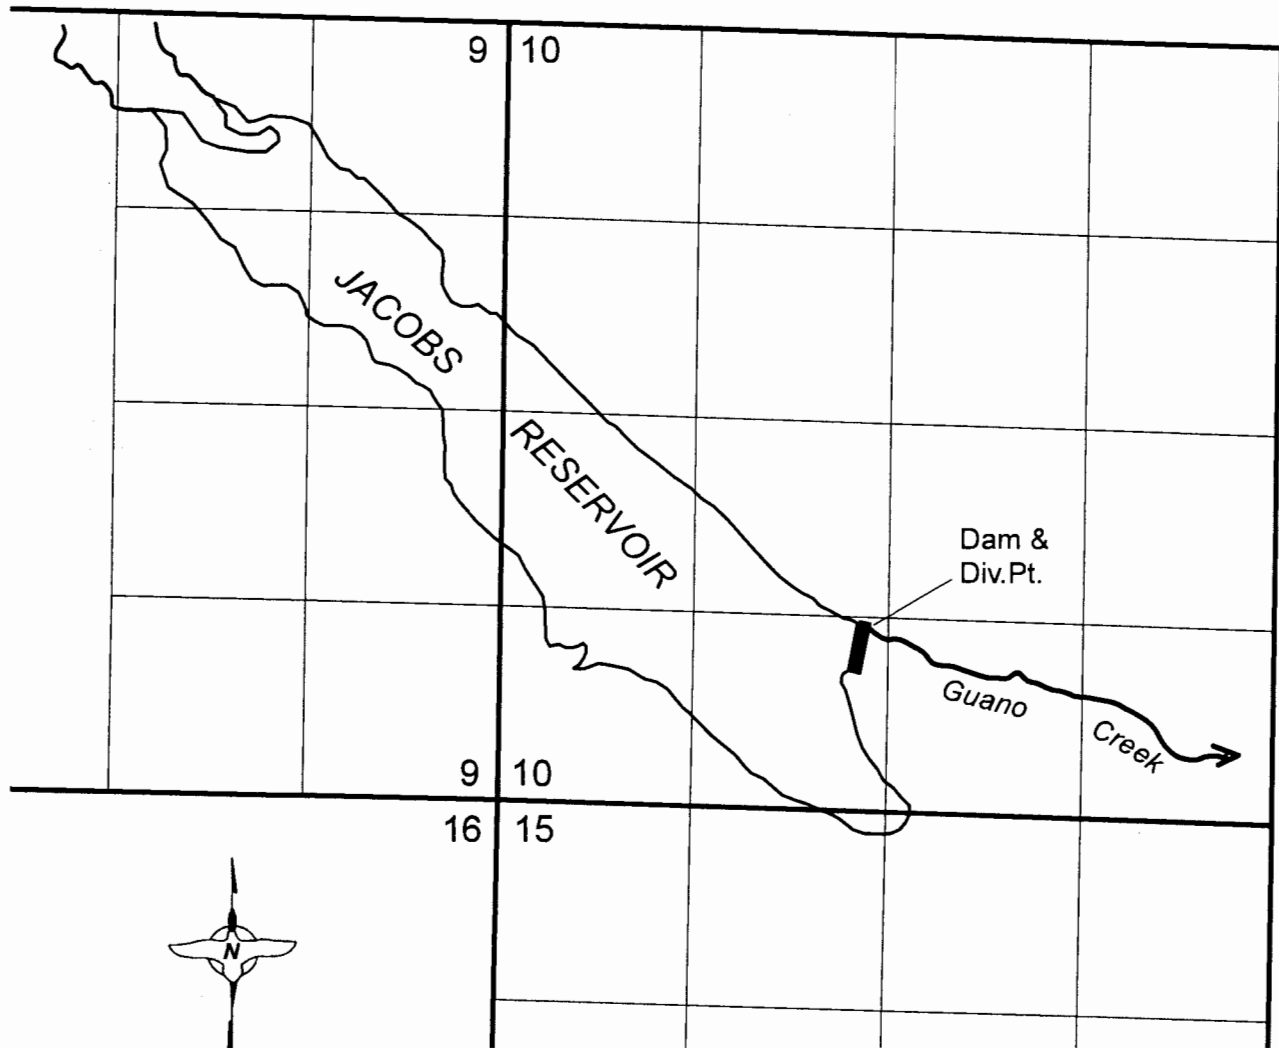

OREGON STATE PLANE GRID NORTH
(SOUTH ZONE, $\theta = + 0^{\circ} 34' 45.2''$)
1 INCH = 1320 FEET

Dam & Div. Pt. is located in the SE $\frac{1}{4}$ SW $\frac{1}{4}$ of Section 10 and is 1240 feet North and 1460 feet East from the SE corner of Section 10
Note: The entirety of Sections 9, 10 and 15 are contained within Tax Lot 100 of T. 38 S., R. 26 E., W.M.

MAP TO ACCOMPANY CLAIM OF BENEFICIAL USE FOR TRANSFER T-8093
IN THE NAME OF THE U.S. FISH & WILDLIFE SERVICE,
HART MOUNTAIN NATIONAL ANTELOPE REFUGE

This map is not intended to provide
legal dimensions or locations of
property ownership lines.

RECEIVED BY CWRD

JUL 06 2012

SALEM, OR



RENEWS: 12/31/2013