

RECEIVED


MAR 12 2012

WATER RESOURCES DEPT
SALEM, OREGON

T. 17S., R. 20E., W.M.



Scale 1" = 1320'
(4" = 1 mile)

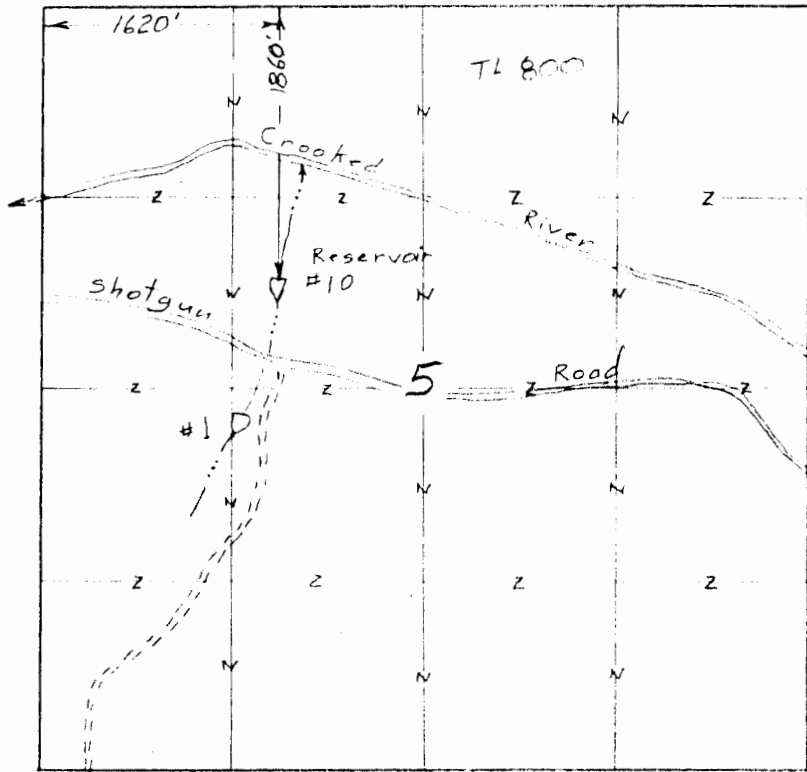


Surveyed July 7, 2011

Claim of Beneficial Use Map
for
SHOTGUN RANCH, LLC

App R-87092

Per R-14638 (Res. #10)

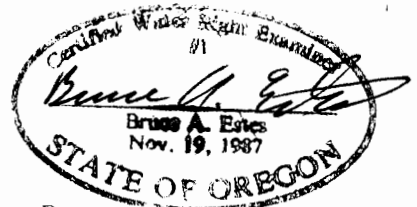

Renewal Dec 31, 2013

This map is for the purpose of
locating a water right only
and has no intent to provide
legal dimensions or the location
of property lines.

ESTES SURVEYS, LLC

PO Box 47519	60382 Arnold Rd
Salem, OR 97306-7519	Bend, OR 97702
(503) 585-7593	(541) 382-7391