


0674

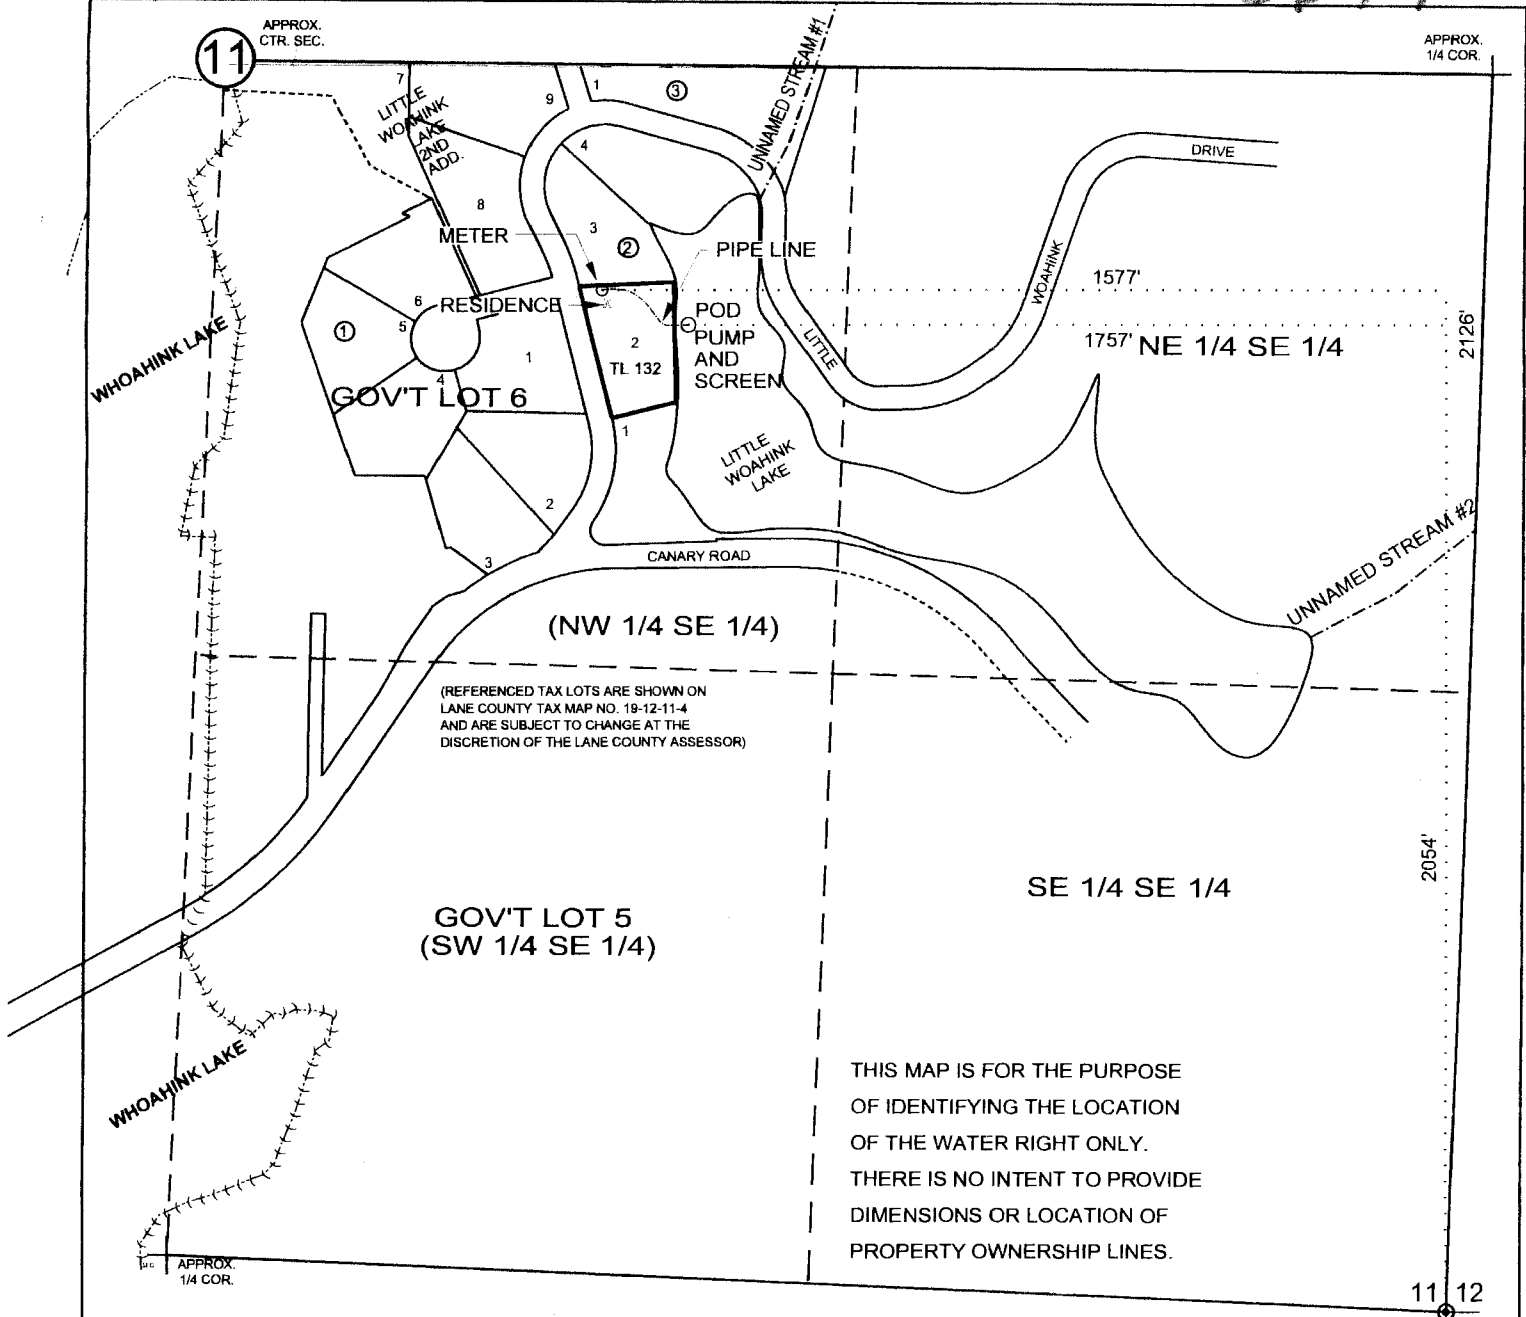

RECEIVED

APR 09 2012

WATER RESOURCES DEPT
SALEM, OREGON

FINAL PROOF SURVEY CLAIM OF BENEFICIAL USE WATER RIGHTS MAP

MID COAST BASIN

UNDER

PERMIT 54687

APPLICATION NO S-86623


NW 1/4 SE 1/4, SEC. 11, T19S, R12W, W.M.

19-12-11-4, TL 132

LANE COUNTY, OREGON

FOR: CHRISTINE MAY AND CAROL RETZER
5445 LITTLE WHOAHINK DR.
FLORENCE, OR 97439

PREPARED BY: WOBBE & ASSOCIATES, INC.
510 KINGWOOD ST. / P.O. BOX 3093
FLORENCE, OR 97439
DATE: MARCH 27, 2012

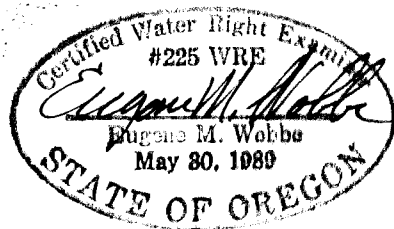

00811149 #

0674 folder 2