

USGS - Dalreed Butte, OR

TOWNSHIP 2 NORTH/SOUTH

RANGE 23 EAST/WEST

SECTION 20, SE, NE



NORTH ARROW

Dimensions of Project,


Proposed Wetland

625' x 312.5'

= 4.5 acres
x 2 ft depth

= 9 acre-feet

Distance
from
survey marker
to center (o)
of project

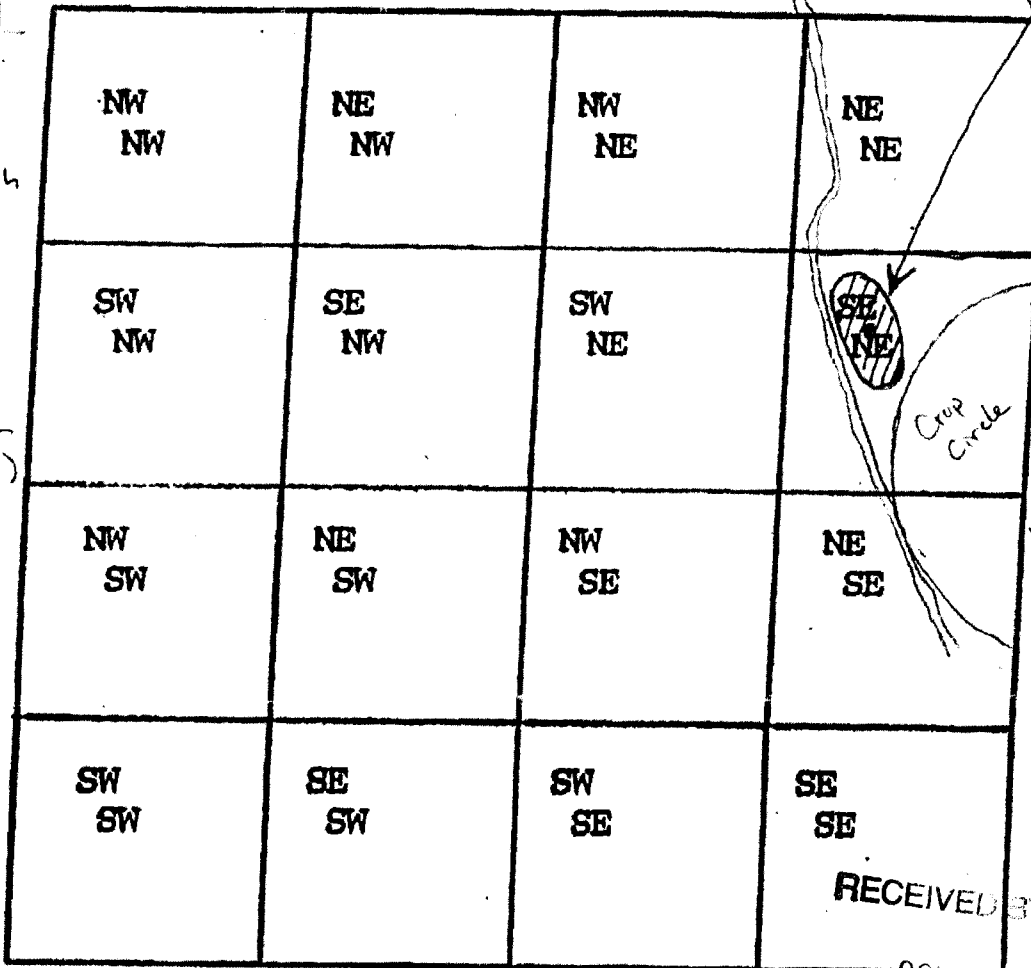

SEC MARKER

RECEIVED BY DW-30

OCT 17 2005

1055' WEST, 1848' SOUTH OF NE CORNER
SECTION 20, T2N, R23E WM SALEM, OR

1 INCH = 1000 FEET

RECEIVED
JUN 19 2006
WATER RESOURCES DEPT
SALEM, OREGON

RECEIVED
MAY 26 2006
WATER RESOURCES DEPT
SALEM, OREGON