

MAP.


Accompanying Proof of Chas B. Howard of Ashland  
Oregon to the waters of Spring tributary to Foley  
Gulch tributary to Emigrant Creek Jackson County Oregon  
for Domestic and Irrigation purposes

June 29 1931

STATE ENGINEER  
RECEIVED

JUL 1 1931

SALEM, OREGON

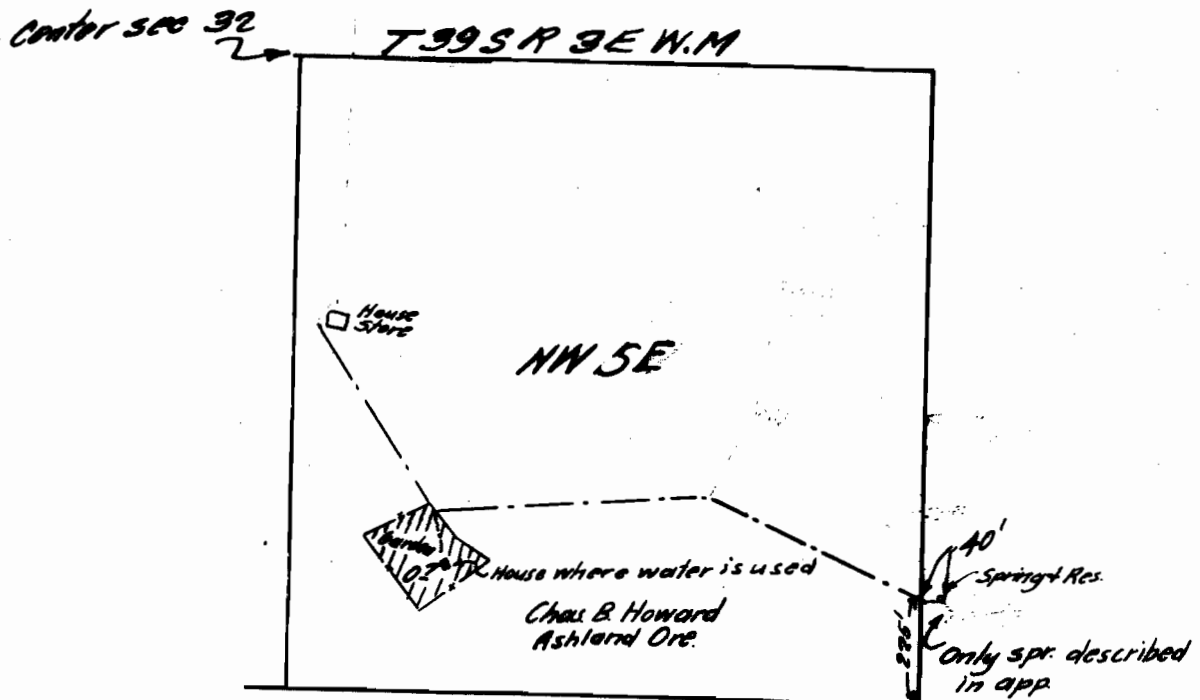


Map made from Plane Table survey by Chester A. Cummings

MAP

Accompanying application of CHARLES B. HOWARD Ashland Oregon for permit to the waters of Spring tributary to Foley Gulch tributary to Emigrant Creek Jackson County, Oregon. for Domestic and Irrigation purposes.

August 29<sup>th</sup> 1928.

Tp 39.5. R.3 E.W.M.

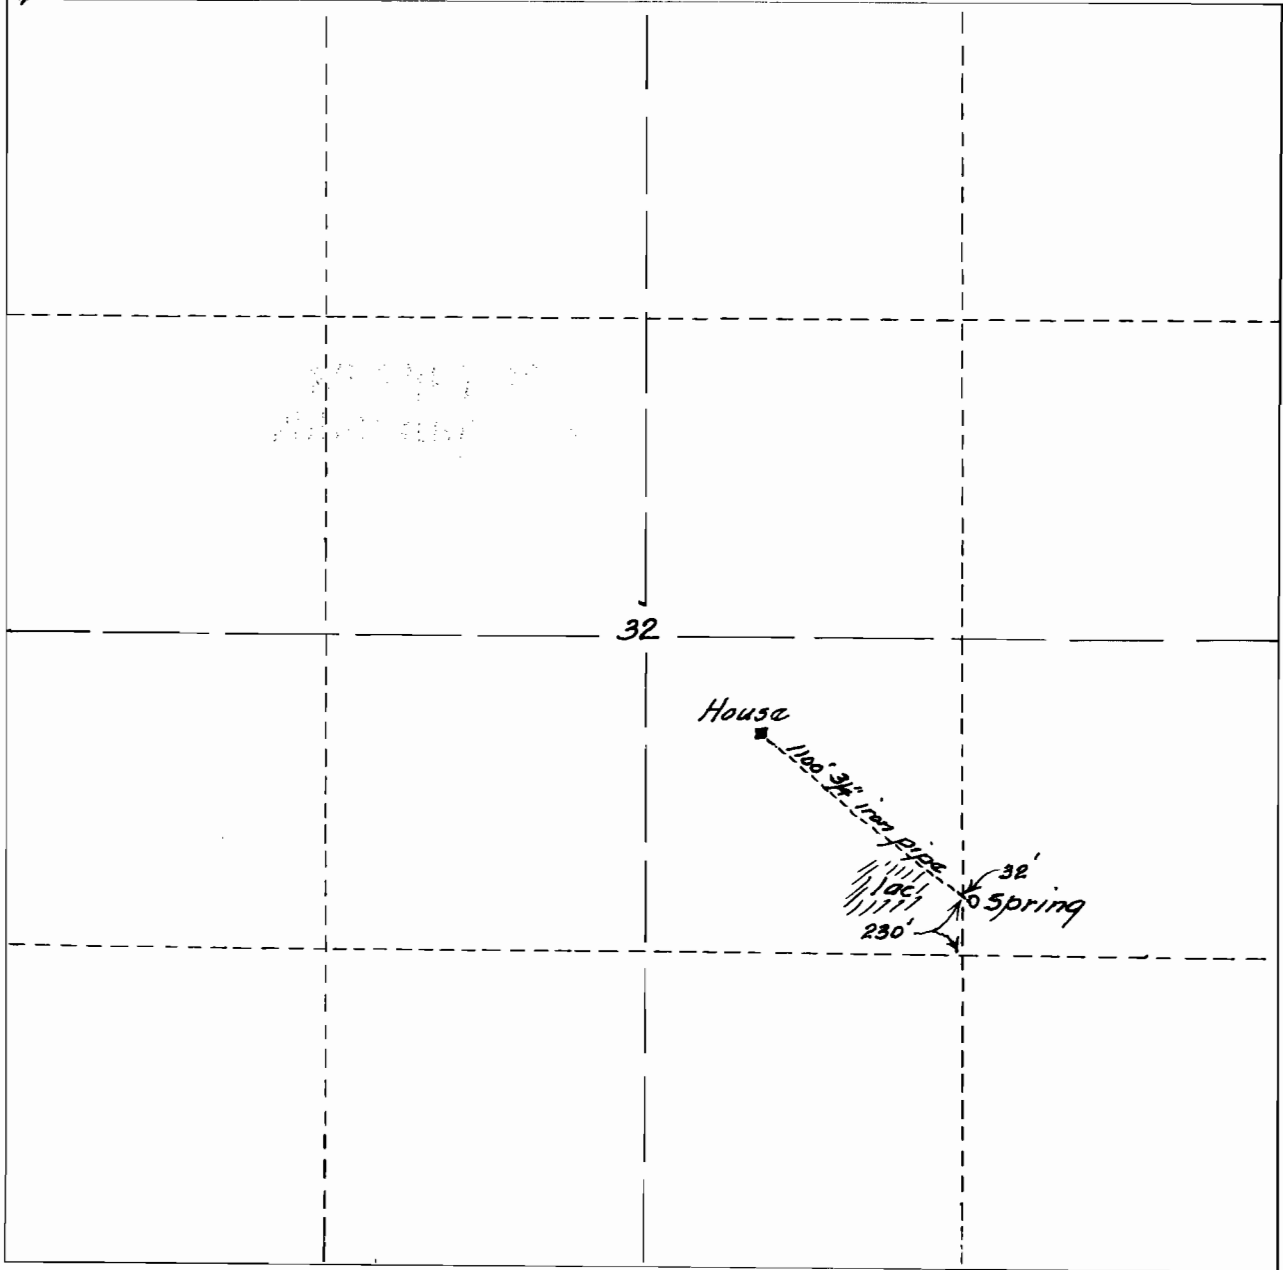

Map made from notes taken by Mr Howard the same correctly showing location of Spring and place of use of waters. compiled by.  
Fred. N. Cummings. C.E.

Application No. 12306  
 Permit No. 18076

12306