

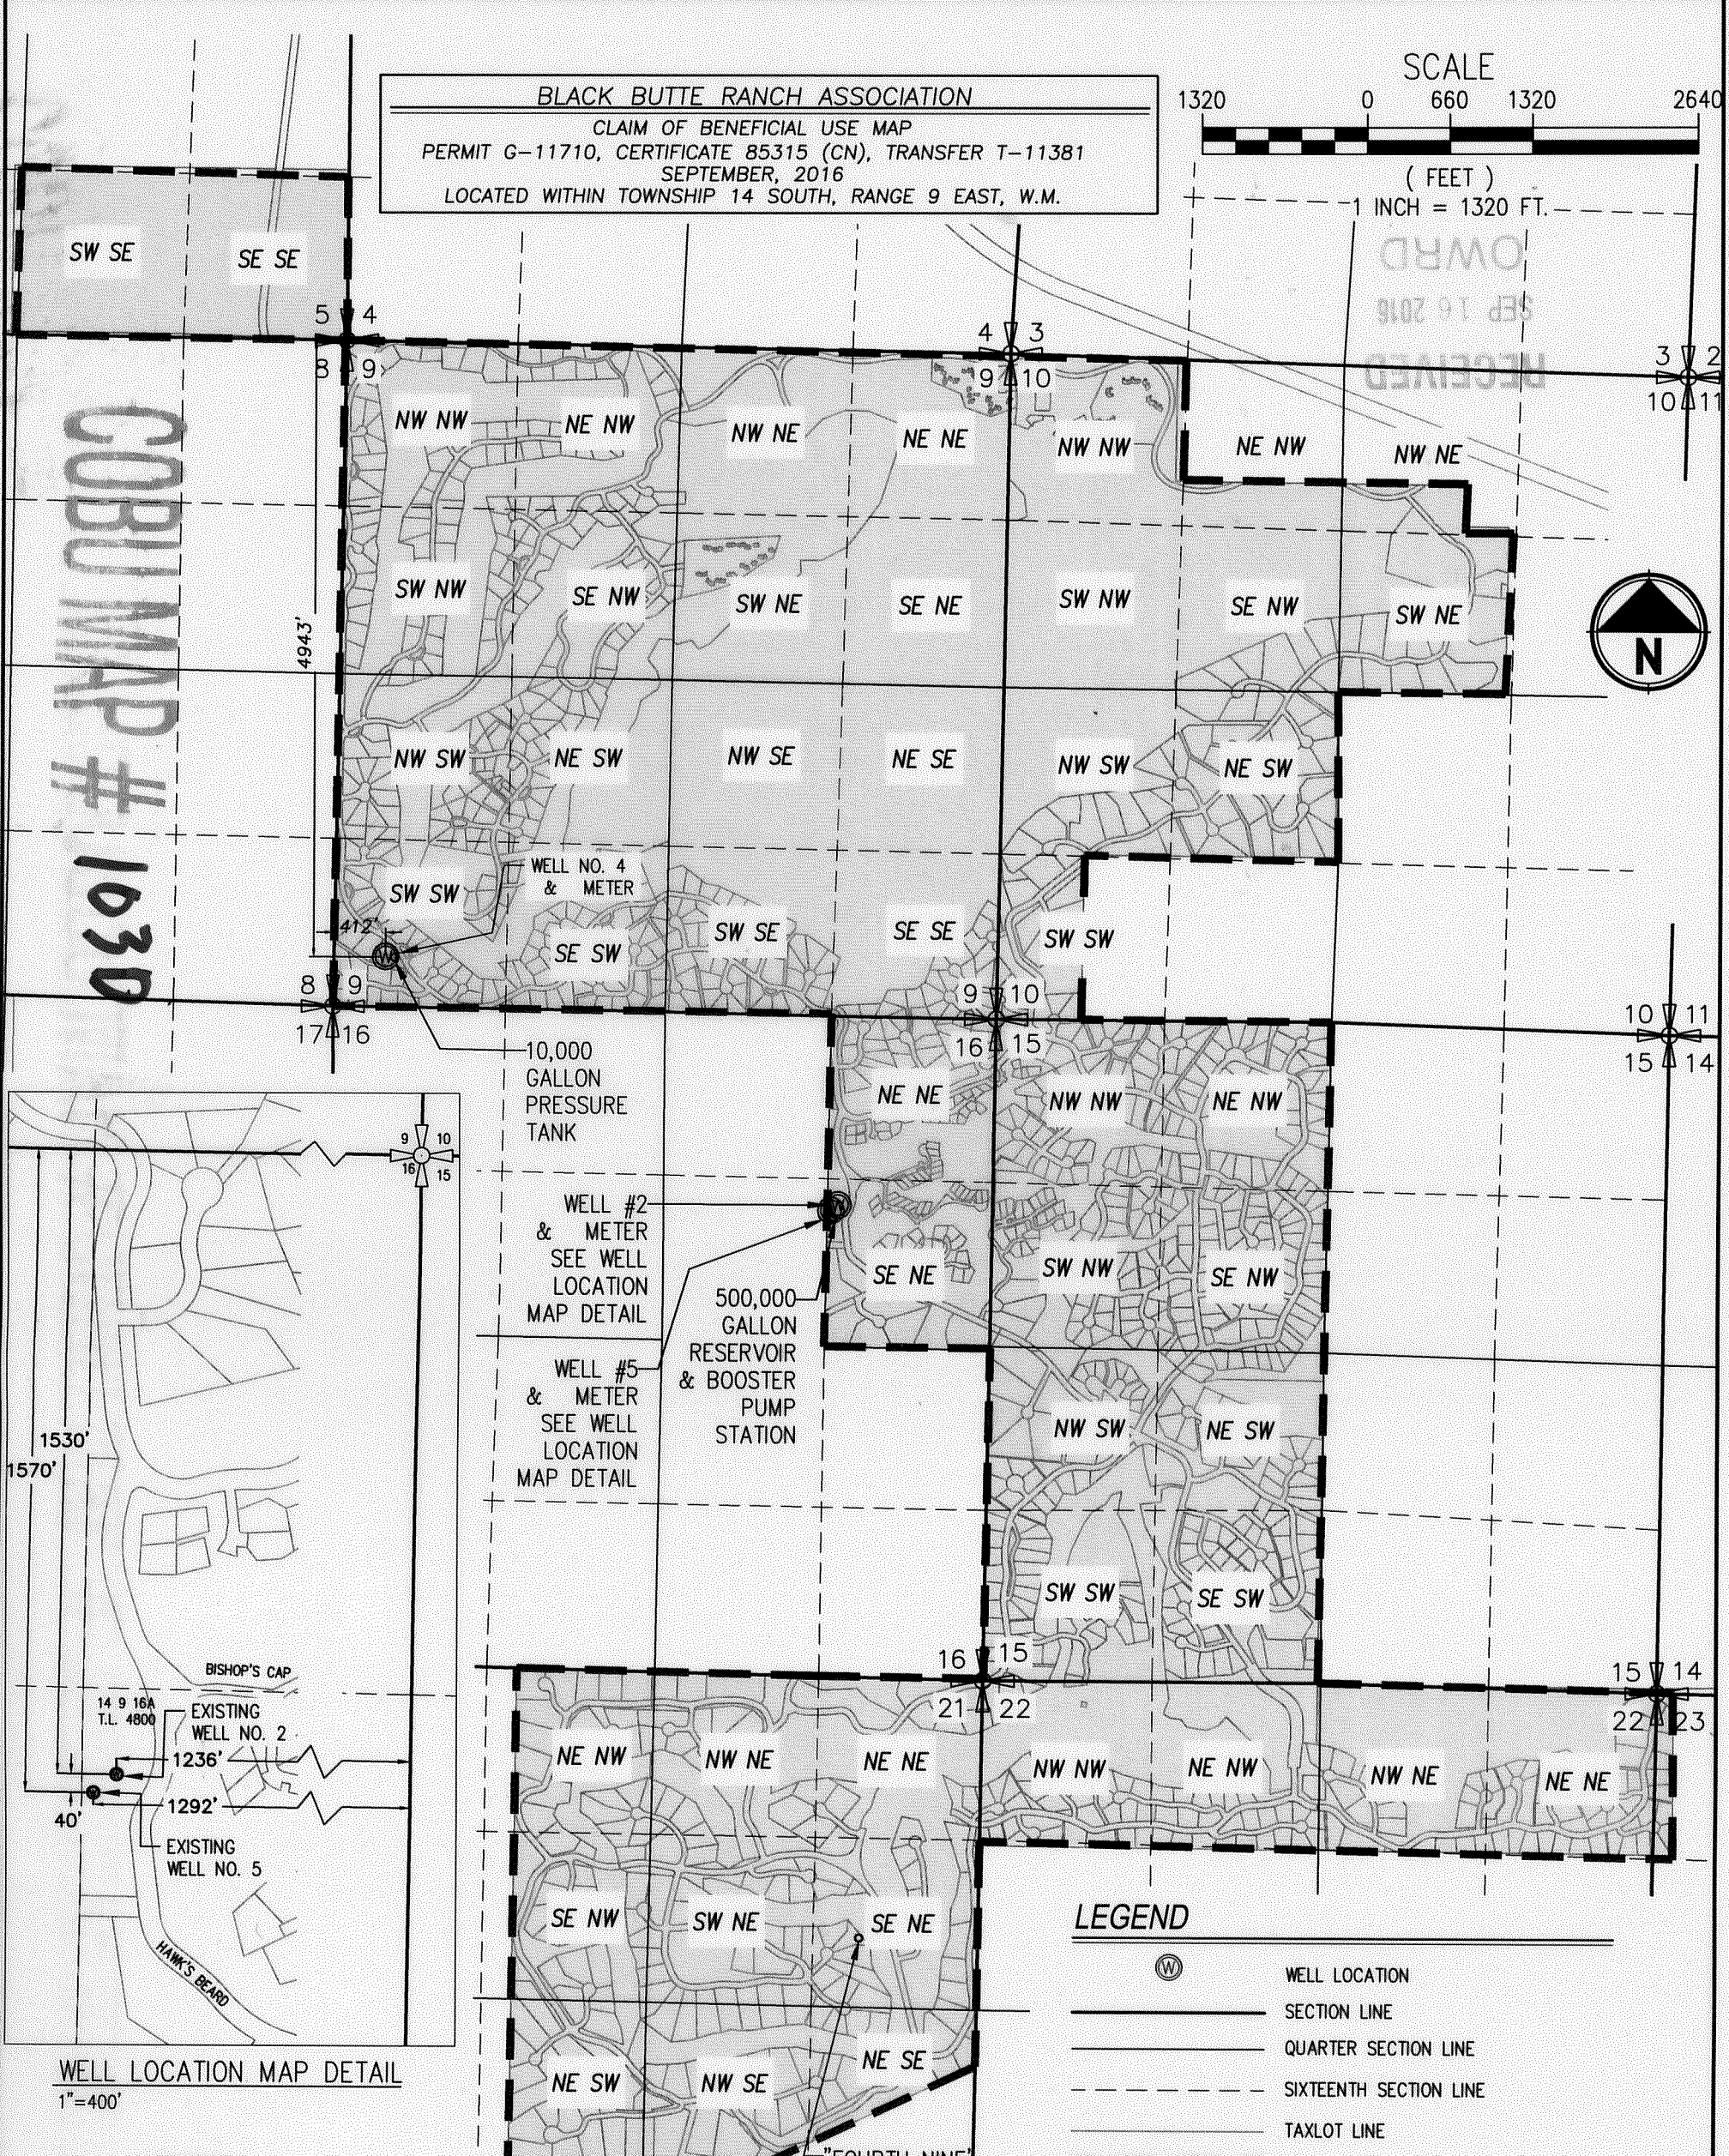


1030

**BLACK BUTTE RANCH ASSOCIATION**  
CLAIM OF BENEFICIAL USE MAP  
PERMIT G-11710, CERTIFICATE 85315 (CN), TRANSFER T-11381  
SEPTEMBER, 2016  
LOCATED WITHIN TOWNSHIP 14 SOUTH, RANGE 9 EAST, W.M.

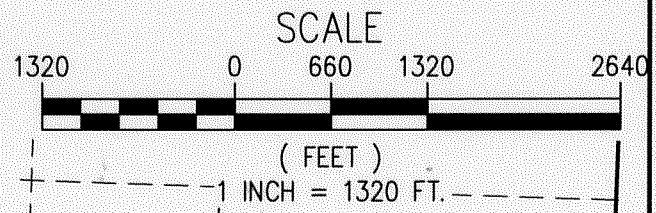

COBU MAP # 1030

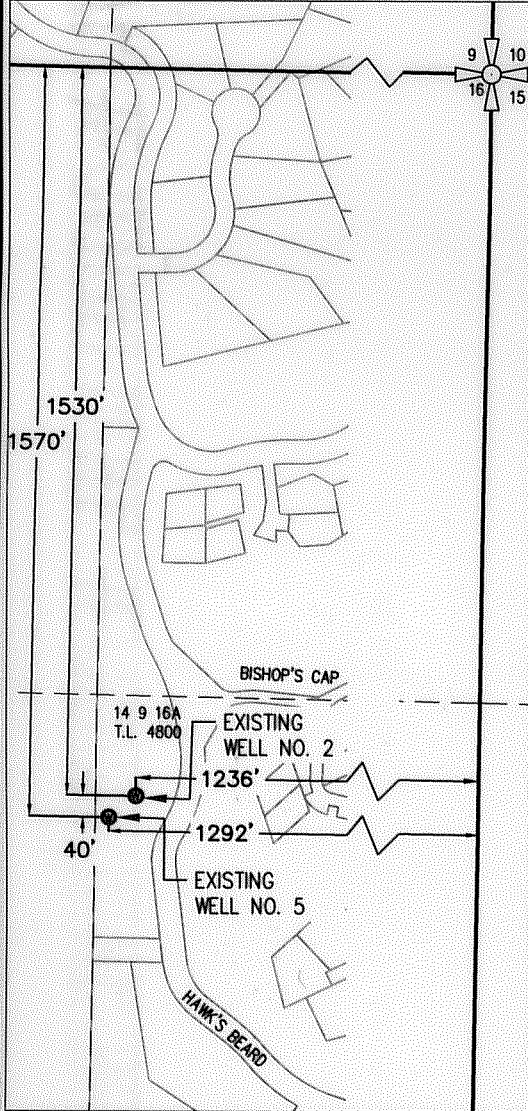


WELL LOCATION MAP DETAIL  
1"=400'

**LEGEND**

- WELL LOCATION
- SECTION LINE
- QUARTER SECTION LINE
- SIXTEENTH SECTION LINE
- TAXLOT LINE
- AREA OF USE FOR QUASI-MUNICIPAL WATER RIGHT. PRIORITY DATE - NOV. 18, 1991
- SECTION CORNER

NOTE: THIS MAP WAS PREPARED FOR THE PURPOSE OF IDENTIFYING THE LOCATION OF WATER RIGHTS. THIS MAP IS NOT INTENDED TO PROVIDE LEGAL DIMENSIONS OR LOCATIONS OF PROPERTY OWNERSHIP LINES.

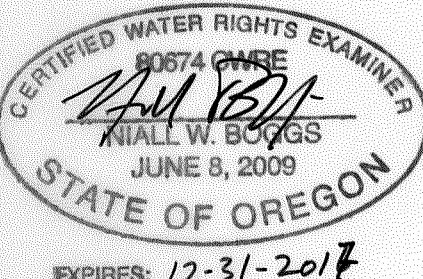

CLAIM OF BENEFICIAL USE MAP  
1"=1320'

DRAWING NO. 1 OF 1  
WR2.0  
**TRANSFER T-11381**

PROJECT NAME  
**CLAIM OF BENEFICIAL USE MAP**  
BLACK BUTTE RANCH CORPORATION AND BLACK BUTTE RANCH ASSOCIATION

PRELIMINARY

**Parametrix**  
ENGINEERING, PLANNING, ENVIRONMENTAL SCIENCES  
595 SW BLUFF DRIVE, SUITE B | BEND, OR 97702  
P 541.508.7710  
WWW.PARAMETRIX.COM

DATE: **SEPTEMBER 2016** DESIGNED: **SCC** CHECKED: **SCC**  
DRAWN: **SCC** APPROVED: **SCC**

REVISIONS	DATE	BY

ONE INCH AT FULL SCALE. IF NOT, SCALE ACCORDINGLY