
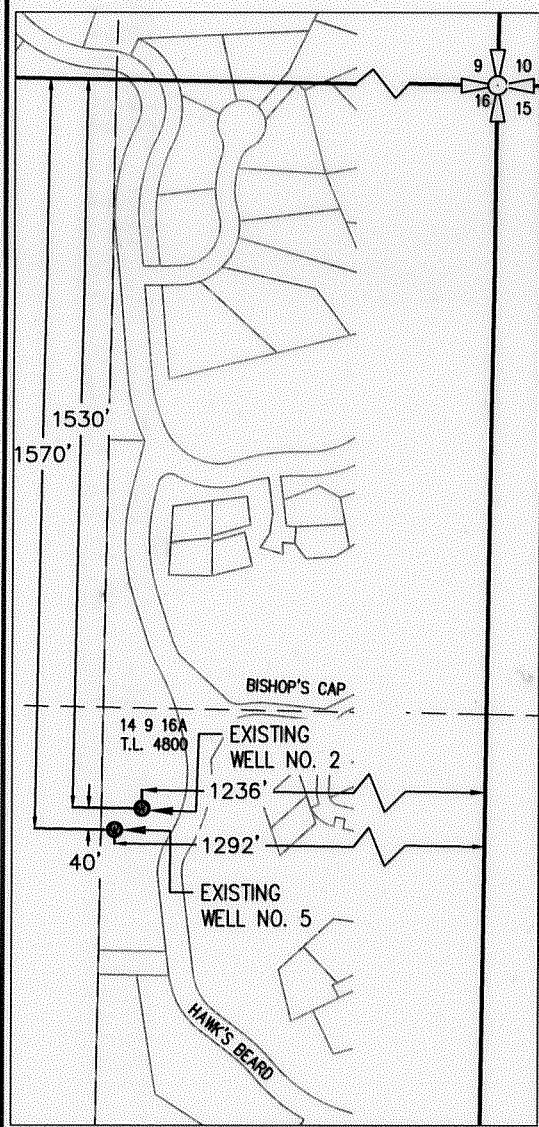
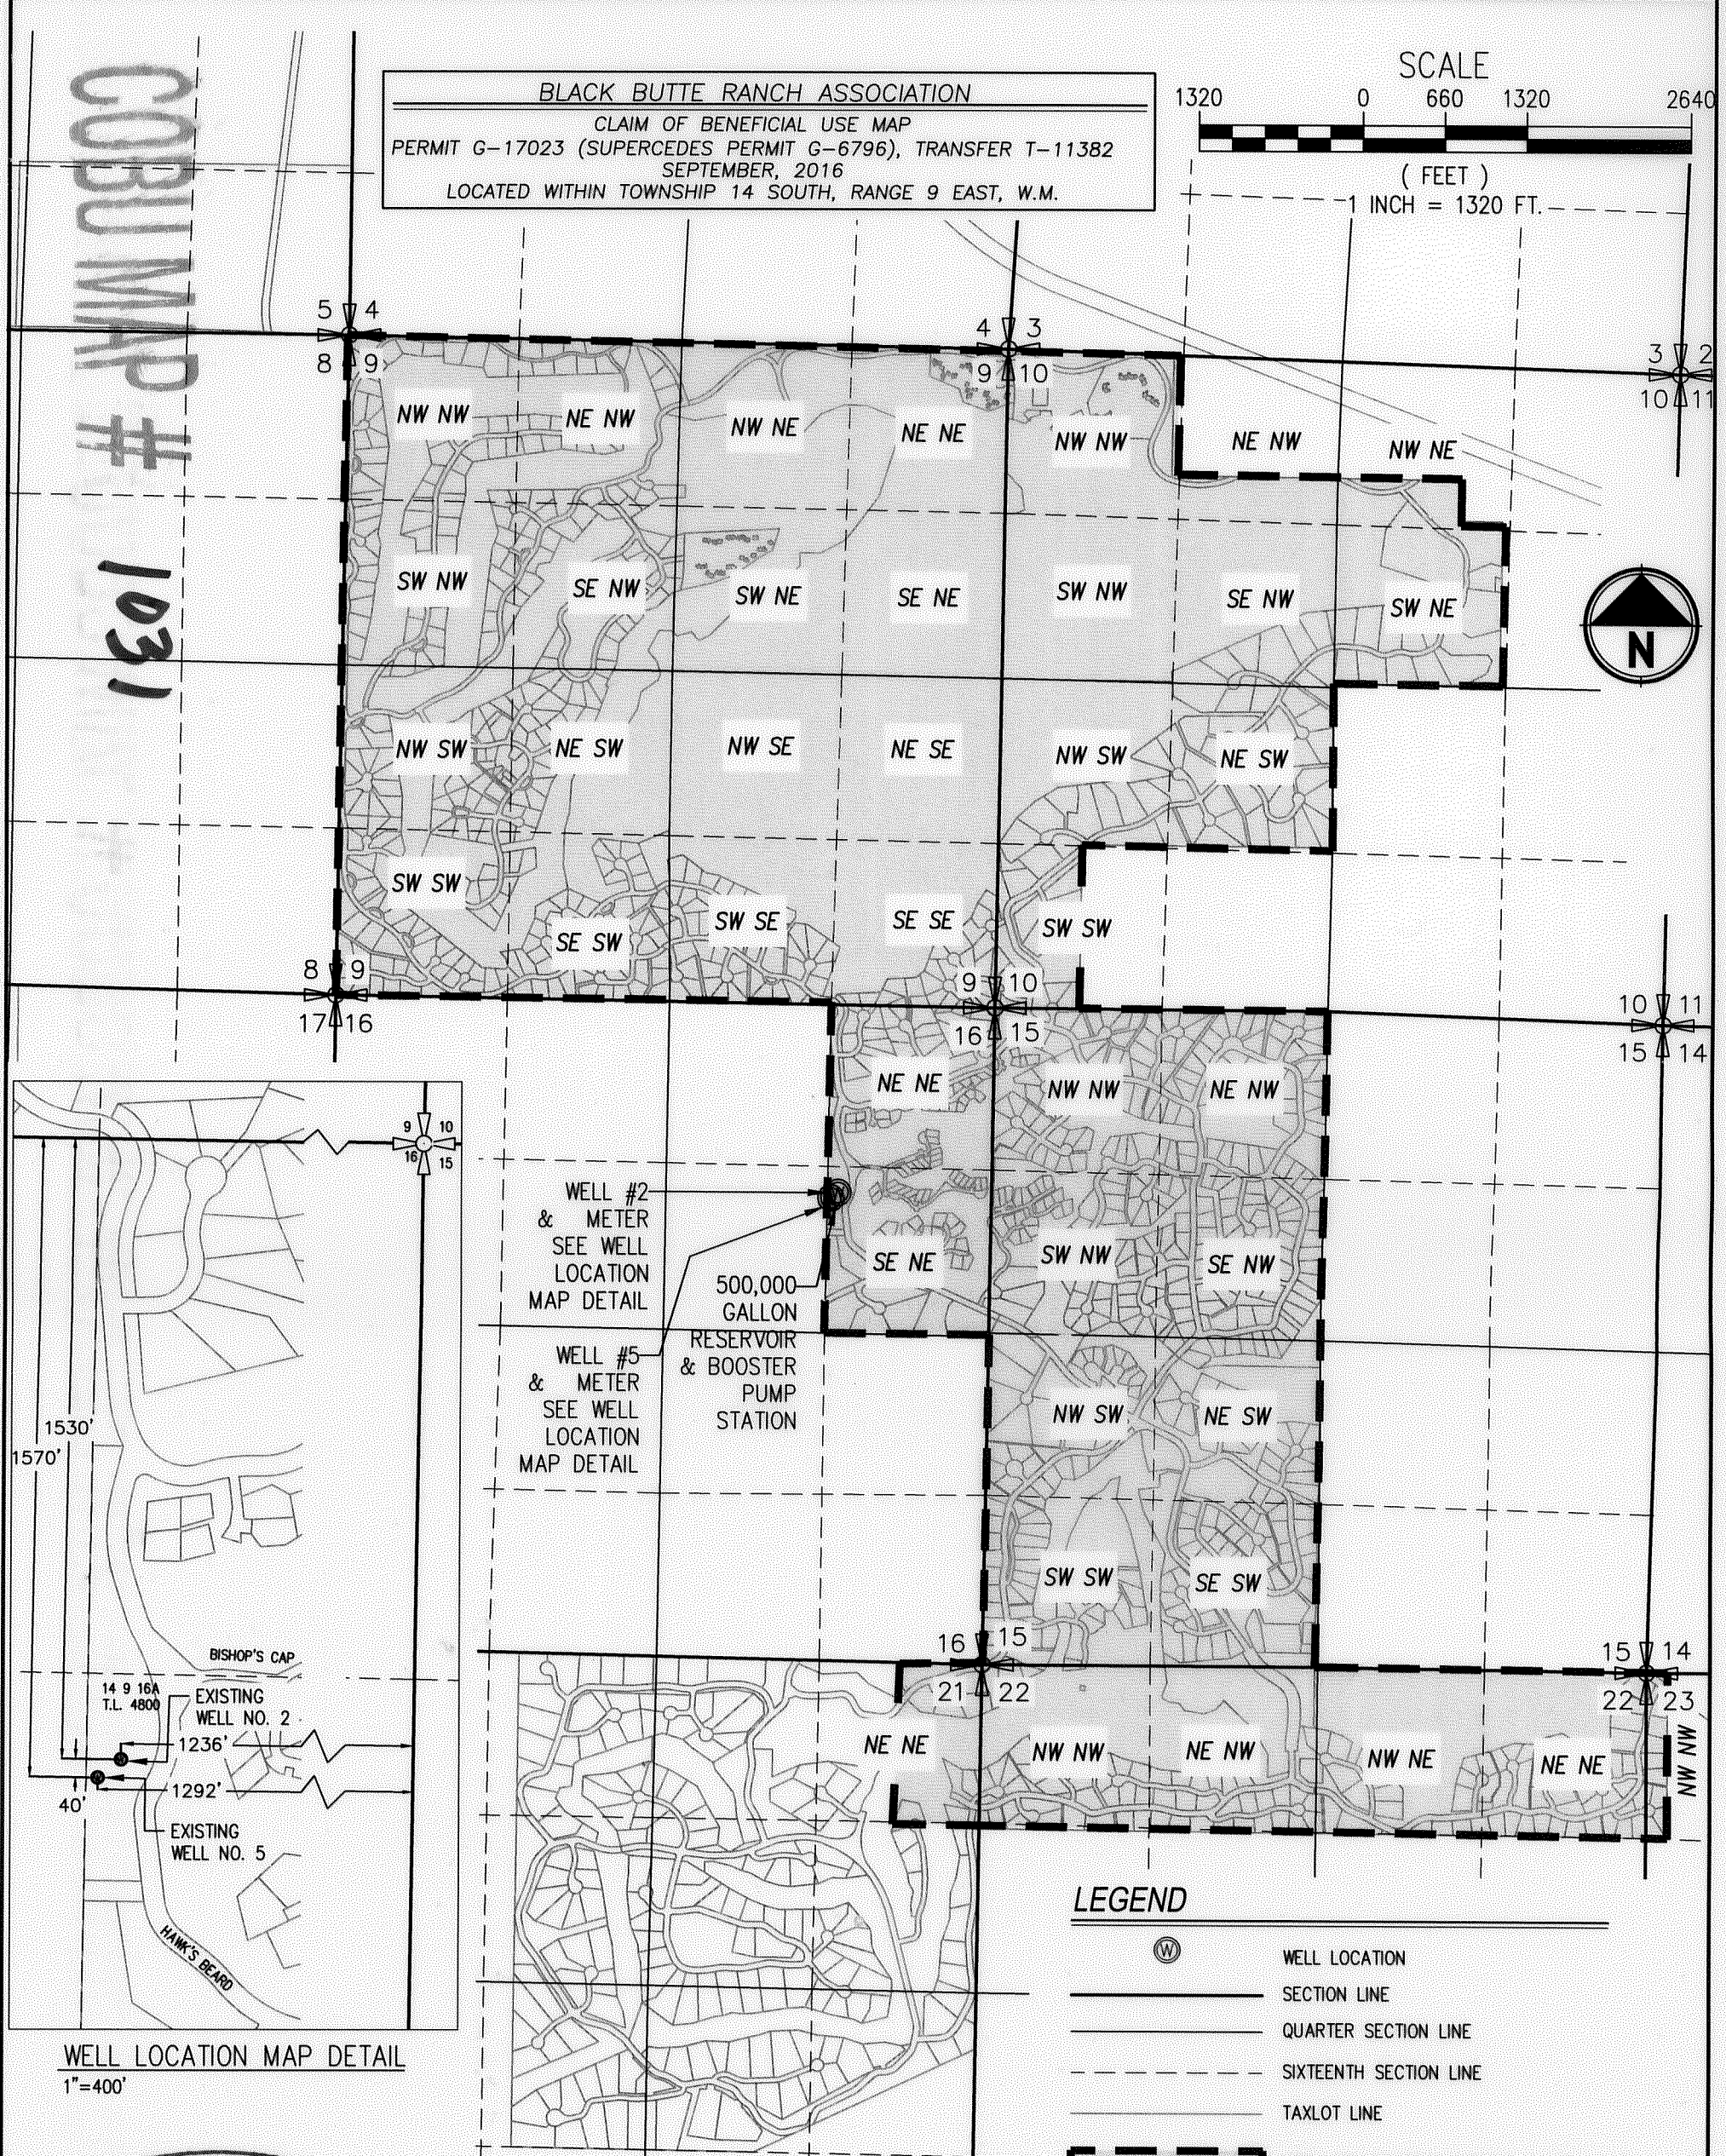


1031

COBU MAP # 1031

BLACK BUTTE RANCH ASSOCIATION
 CLAIM OF BENEFICIAL USE MAP
 PERMIT G-17023 (SUPERCEDES PERMIT G-6796), TRANSFER T-11382
 SEPTEMBER, 2016
 LOCATED WITHIN TOWNSHIP 14 SOUTH, RANGE 9 EAST, W.M.

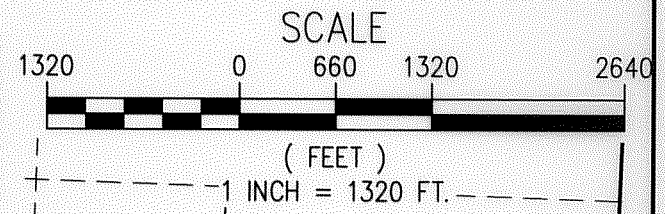

WELL LOCATION MAP DETAIL
1"=400'

LEGEND

- WELL LOCATION
- SECTION LINE
- QUARTER SECTION LINE
- SIXTEENTH SECTION LINE
- TAXLOT LINE
- AREA OF USE FOR DOMESTIC WATER RIGHT. PRIORITY DATE - JUNE. 25, 1975
- SECTION CORNER

NOTE: THIS MAP WAS PREPARED FOR THE PURPOSE OF IDENTIFYING THE LOCATION OF WATER RIGHTS. THIS MAP IS NOT INTENDED TO PROVIDE LEGAL DIMENSIONS OR LOCATIONS OF PROPERTY OWNERSHIP LINES.



RECEIVED
 SEP 16 2016
 OWRD

CLAIM OF BENEFICIAL USE MAP
 1"=1320'

DRAWING NO. 1 OF 1 WR3.0	TRANSFER T-11382	PROJECT NAME CLAIM OF BENEFICIAL USE MAP BLACK BUTTE RANCH PROPERTY MANAGEMENT CORPORATION	Parametrix ENGINEERING · PLANNING · ENVIRONMENTAL SCIENCES 595 SW BLUFF DRIVE, SUITE B BEND, OR 97702 P 541.508.7710 WWW.PARAMETRIX.COM DATE: SEPTEMBER 2016 DESIGNED: SE/AMB JOB No. 297-7391-001 DRAWN: SOB APPROVED:	REVISIONS <table border="1" style="width: 100%; border-collapse: collapse;"> <tr><th>NO.</th><th>DATE</th><th>BY</th></tr> <tr><td> </td><td> </td><td> </td></tr> <tr><td> </td><td> </td><td> </td></tr> </table>	NO.	DATE	BY							ONE INCH AT FULL SCALE. IF NOT SCALE ACCORDINGLY
	NO.	DATE	BY											
PRELIMINARY														