


SECTION 19, TWP.3 S., RANGE 16 E., W.M. SHERMAN COUNTY, OREGON

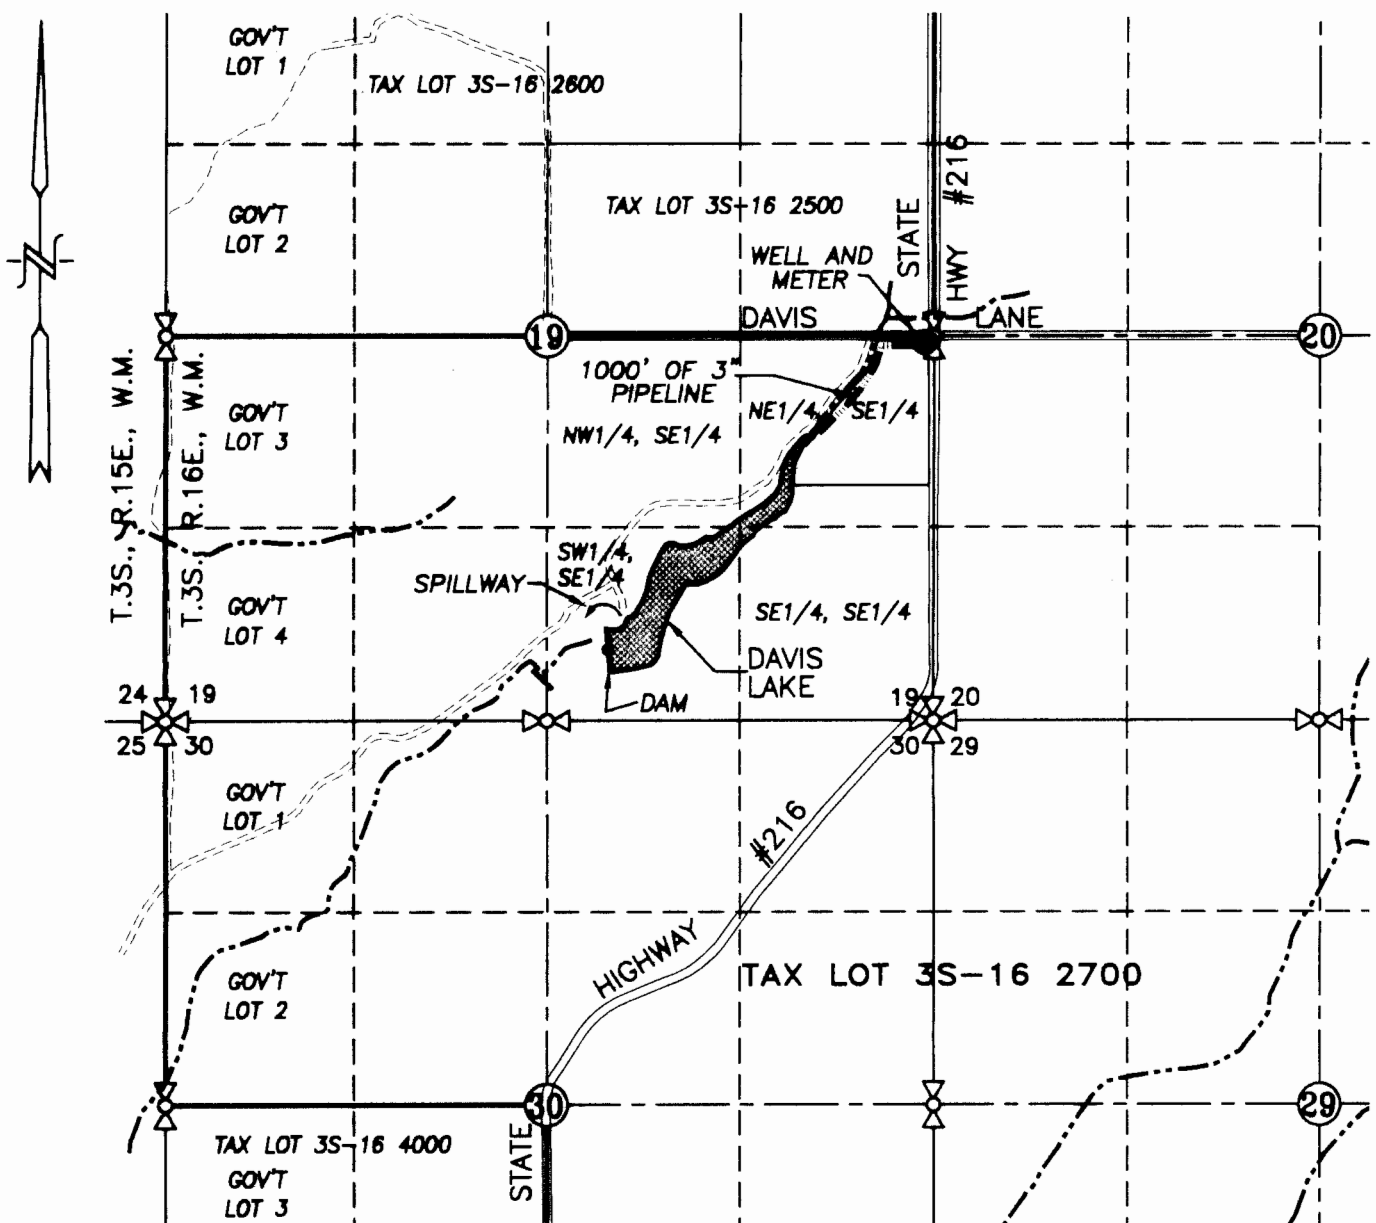

⊙ WELL: 50'S. & 50'W. OF NE COR. OF S1/2, SEC. 19

—— MAINLINE

DAVIS DAM: 486' N. AND 2218' W. OF THE SE CORNER SECTION 19

CLAIM OF BENEFICIAL USE MAP

SCALE: 1" = 1320'



FEB 10 2011

APPLICATION No. G-15736


PERMIT No. G-15897

IN THE NAME OF:

FRED JUSTESEN

DATE: DECEMBER 1, 2010

BY: **TENNESON ENGINEERING CORP.**
3313 W. 2ND. STREET, SUITE 100
THE DALLES, OREGON. 97058
PH. 541-296-9177
FAX 541-296-6657

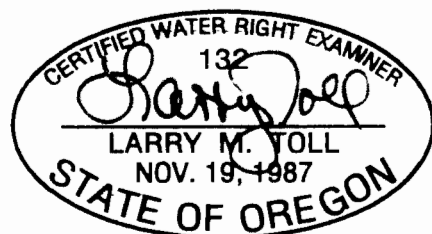

EXPIRES: 06/30/2012

NOTE:

"THIS MAP IS NOT INTENDED TO
PROVIDE DIMENSIONS OR LOCATIONS
OF PROPERTY OWNERSHIP LINES."

W.O. #11132wr3