


# T19S R47E Section 8, W.M.

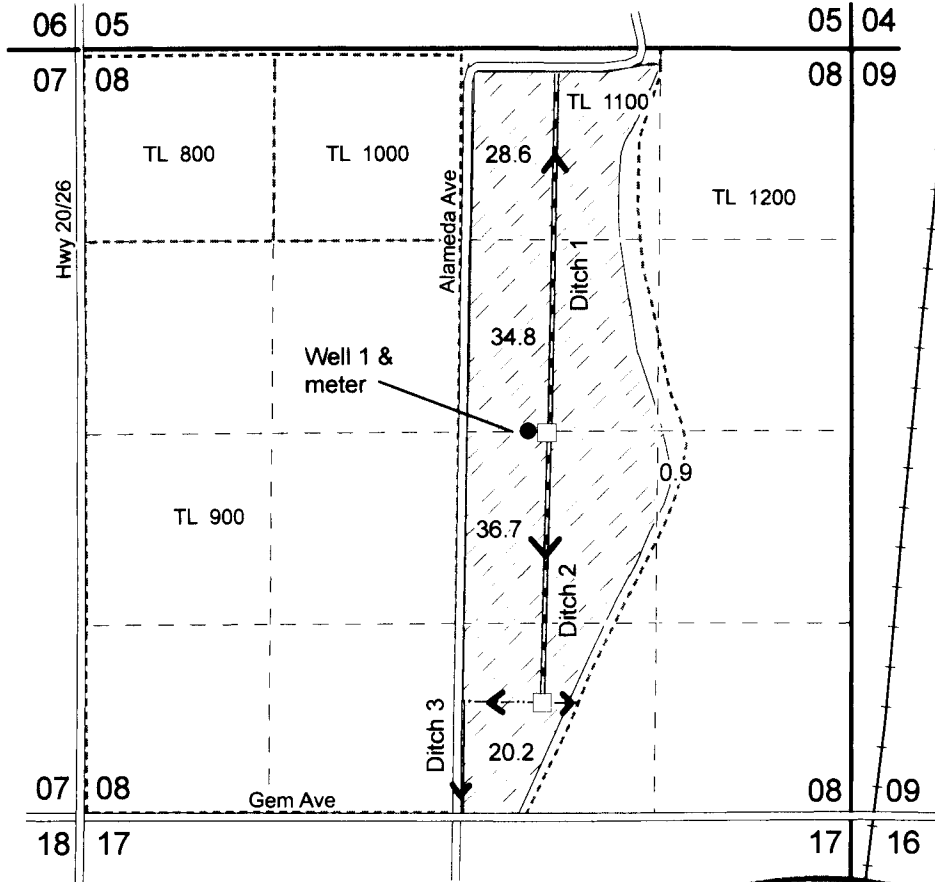

*Expires 12/31/2012*

Well 1 (Malh 1928) is located 450 feet east of the center of section 8.

This map is not intended to provide legal dimensions or locations of property ownership lines

- Well
- Distribution box
- ▭ Place of Use
- Ditch
- Pipe
- - - Quarter Quarter Lines
- Section Lines
- - - Tax Lot Lines
- Roads
- Railroad

0 660 1,320  
Feet

1 in = 1,320 ft



Nancy Rorick Consulting

Claim of Beneficial Use  
Tax Lot 1100  
James Farmer, Charles Warren Farmer  
& Margaret M. Farmer  
Application No. G14985 and Permit No. G13806