

RECEIVED


NOV 07 1995

WATER RESOURCES DEPT
SALEM, OREGON

S1,T4 S,R1W,WILLAMETTE MERIDIAN

MARION COUNTY

SCALE: 4"=1 mile

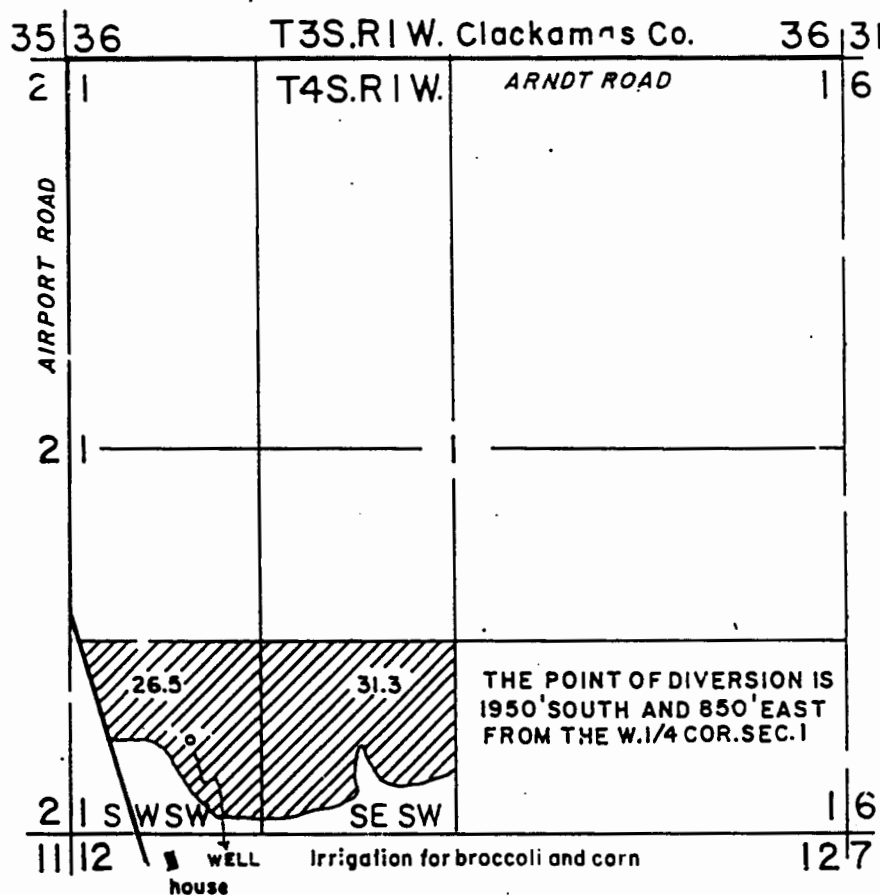


FINAL PROOF SURVEY
UNDER

Application No.G-12647 Permit No.G-11653
IN NAME OF

CARL AND HAZEL SNYDER

THE PURPOSE OF THIS MAP IS TO IDENTIFY THE LOCATION OF THE
WATER RIGHT. IT IS NOT INTENDED TO PROVIDE INFORMATION RELATIVE
TO THE LOCATION OF PROPERTY OWNERSHIP BOUNDARY LINES.

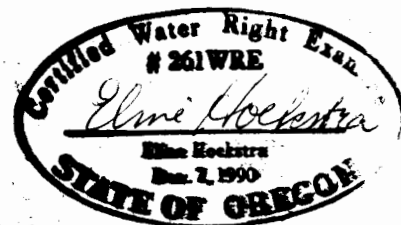

ELINE HOEKSTRA