


T21S, R27E, W.M.
Harney County, Oregon

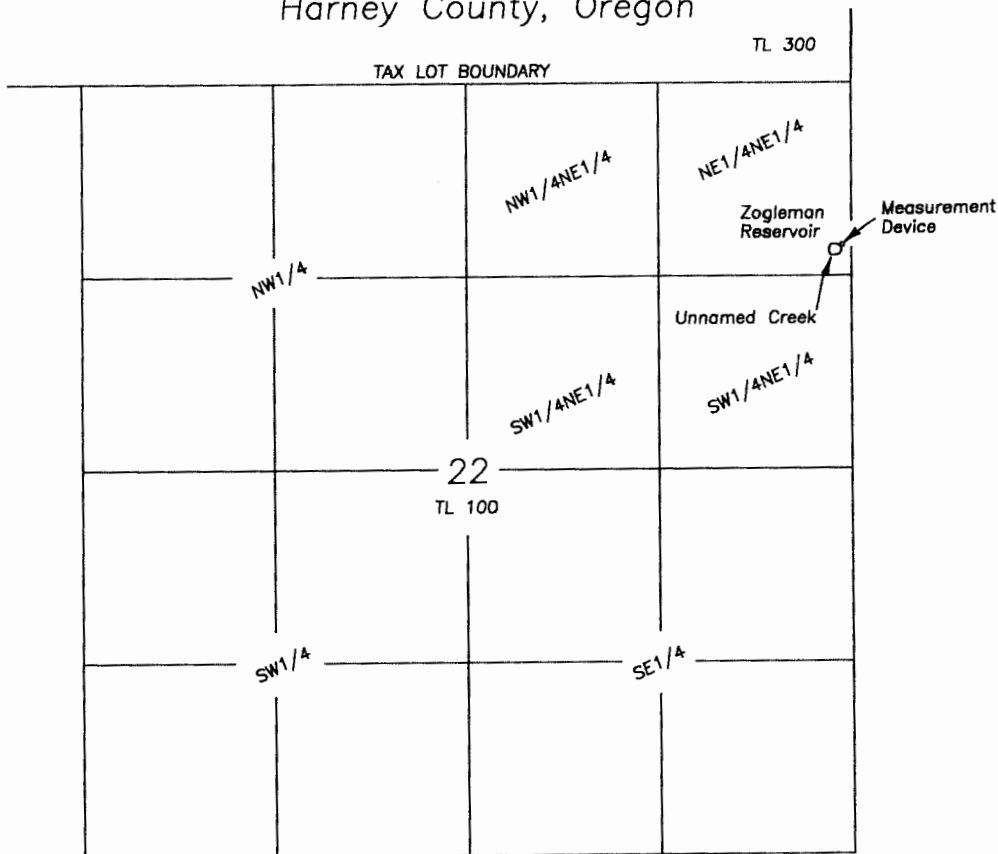

SCALE 1"=1320'

Outlet is located 1120' South & 70' West of the
NE corner of Section 22.

Measuring device is located 2' South of the Outlet

FINAL PROOF SURVEY
CLAIM OF BENEFICIAL USE
ZOGLEMAN RESERVOIR

LEGEND

Application No. R-59647
Permit No. R-8082
Priority 12/21/1979

A portion of Tax Lot
21-27 TL 100

NOTE: Tax Lot 100 is owned by the BLM
and is more that 20,000 acres.
Therefore only a portion of the tax
lot boundary can be shown.

For

Bureau of Land Managment
August 31, 2016

Prepared by

Cornerstone Surveying, Inc

P.O. BOX 33
JOHN DAY, OR. 97845
(541)575-1813

cornerstonesurvey@centurytel.net

RECEIVED BY OWRD

SEP 19 2016

SALEM, OR

NOTE: The preparation of this map
was for the purpose of identifying
the location of the proposed water
right and has no intent to provide
dimensions or location of property
ownership lines.

