


T21S, R27E, W.M.
Harney County, Oregon

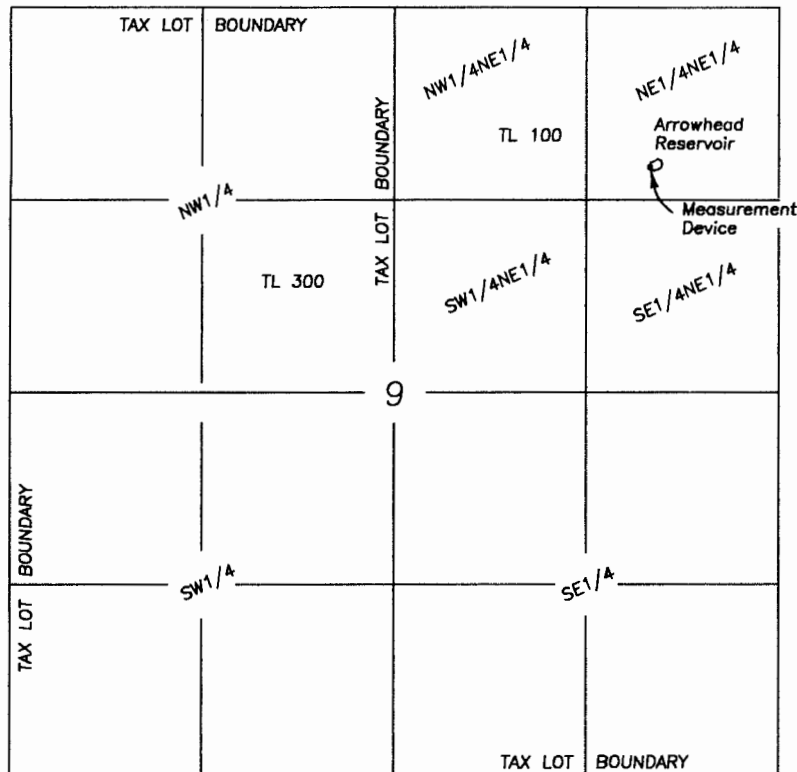

SCALE 1"=1320'

Measurement device is located 1090'S & 880'W of the
NE corner of Section 9.

FINAL PROOF SURVEY
CLAIM OF BENEFICIAL USE
ARROWHEAD RESERVOIR

LEGEND

Application No. R-59645
Permit No. R-8080
Priority 12/21/1979

A portion of Tax Lot
21-27 TL100

NOTE: Tax Lot 100 is owned by the BLM
and is more that 20,000 acres.
Therefore only a portion of the tax
lot boundary can be shown.

For

Bureau of Land Managment
August 29, 2016

Prepared by

Cornerstone Surveying, Inc
P.O. BOX 33
JOHN DAY, OR. 97845
(541)575-1813
cornerstonesurvey@centurytel.net

NOTE: The preparation of this map
was for the purpose of identifying
the location of the proposed water
right and has no intent to provide
dimensions or location of property
ownership lines.

RECEIVED BY OWRD

SEP 19 2016

SALEM, OR

