


T.5S. R.2E. Sec. 7 & 8, W.M.

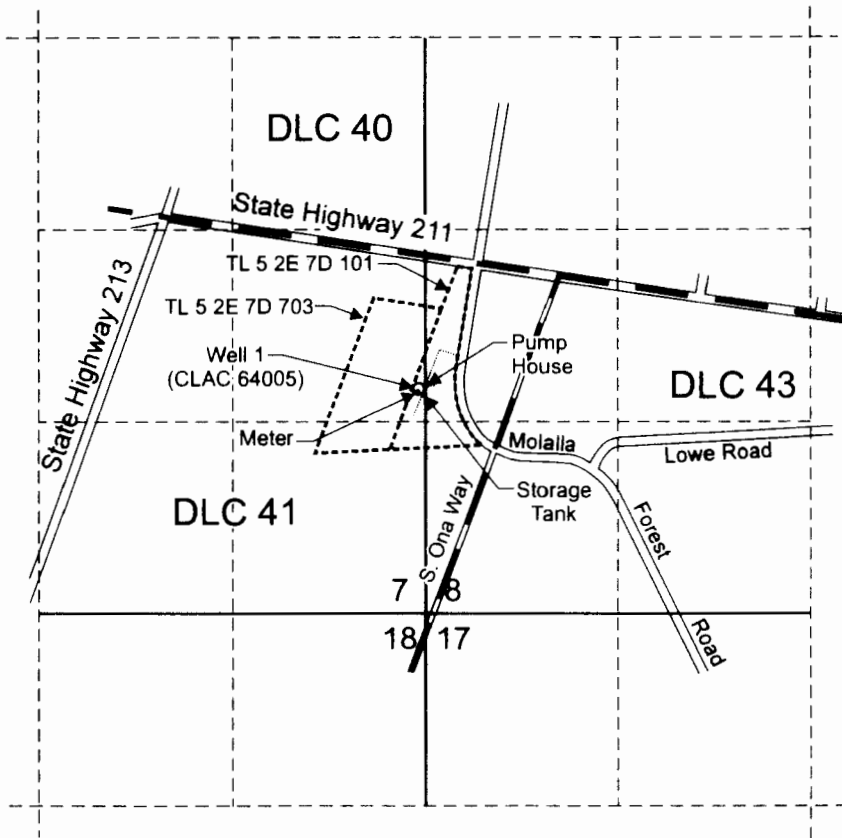

Well 1 (CLAC 64005) is located 1,540 feet north and 50 feet east from the SE corner of Section 7.

----- Tax lot boundary

————— Water main line



EXPIRATION DATE: 6/30/2013

Scale: 1" = 1,320'



This map was prepared for the purpose of identifying the location of a water right only and is not intended to provide legal dimensions or location of property ownership lines.



Claim of Beneficial Use Map
Application G-16501, Permit G-16048

Molalla Redi-Mix
T.5S. R.2E. Sec. 7 & 8, W.M.

Pacific Hydro-Geology Inc.

08/2011