


FINAL PROOF MAP

TO ADD A POINT OF APPROPRIATION
FOR PERMIT G-15634
JAMES EDWARDS

TOWNSHIP 16 SOUTH, RANGE 16 EAST, SECTION 23, W.M.
TAX LOTS: 4800, 4900 & 5000

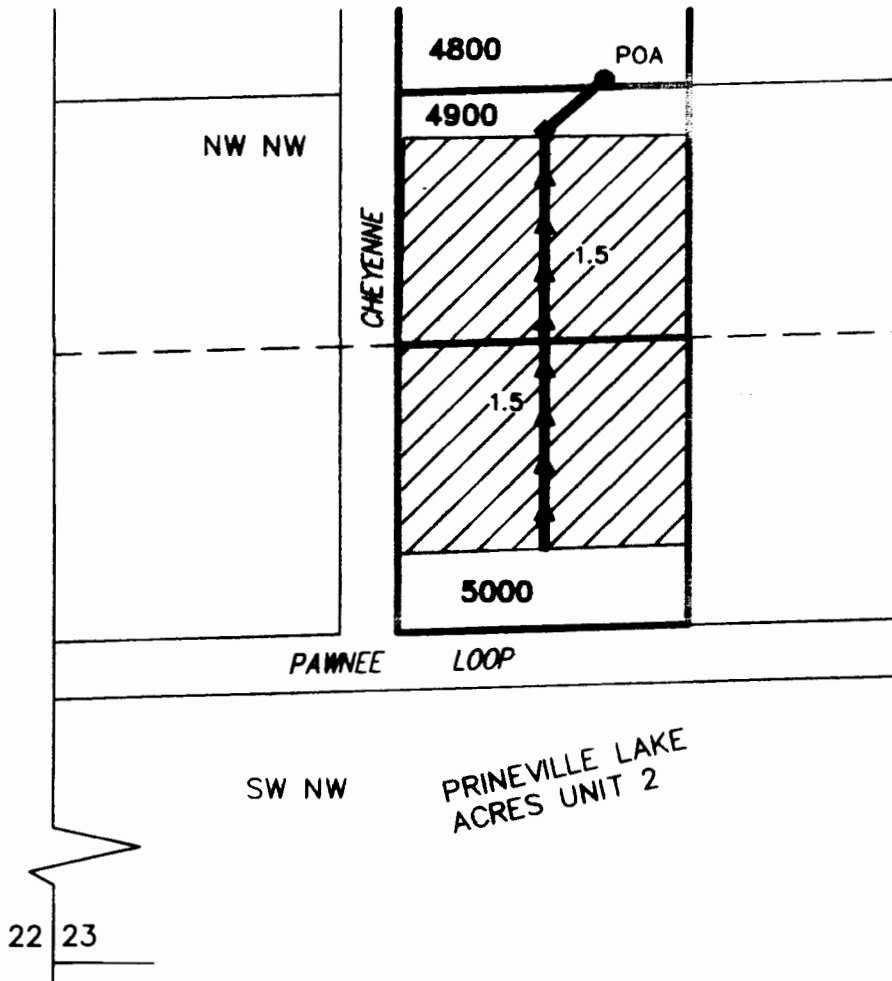

RENEWAL DATE: 12/31/2012

RECEIVED

WATER RESOURCES DEPT
SALES DIVISION

● **POA (CROO 535)**

NEW WELL IN THE NW1/4 OF THE NW1/4 OF SECTION 23
LOCATED 1800 FEET NORTH AND 570 FEET EAST FROM THE
WEST 1/4 CORNER OF SECTION 23, TOWNSHIP 16 SOUTH,
RANGE 16 EAST, W.M., CROOK COUNTY, OREGON

THIS MAP IS FOR THE PURPOSE OF LOCATING A WATER
RIGHT ONLY AND HAS NO INTENT TO PROVIDE LEGAL
DIMENSIONS OR THE LOCATION OF PROPERTY LINES



3.0 ACRES FROM G-15634, AS SHOWN



1-INCH PVC MAIN



HOSEBIB RISER



METER & SHUTOFF VALVE

PREPARED FOR:

JAMES EDWARDS
14382 S CHEYENNE
PRINEVILLE, OR 97754

PREPARED BY:



ALL POINTS ENGINEERING AND SURVEYING, INC.
P.O. BOX 767 (CRR) TERREBONNE, OR 97760
(541) 548-5833
www.APEandS.com