


T. 7 S., R. 45 E., W.M.

RECEIVED

NOV 15 1993

PLANNING & ZONING DEPARTMENT  
CLERK

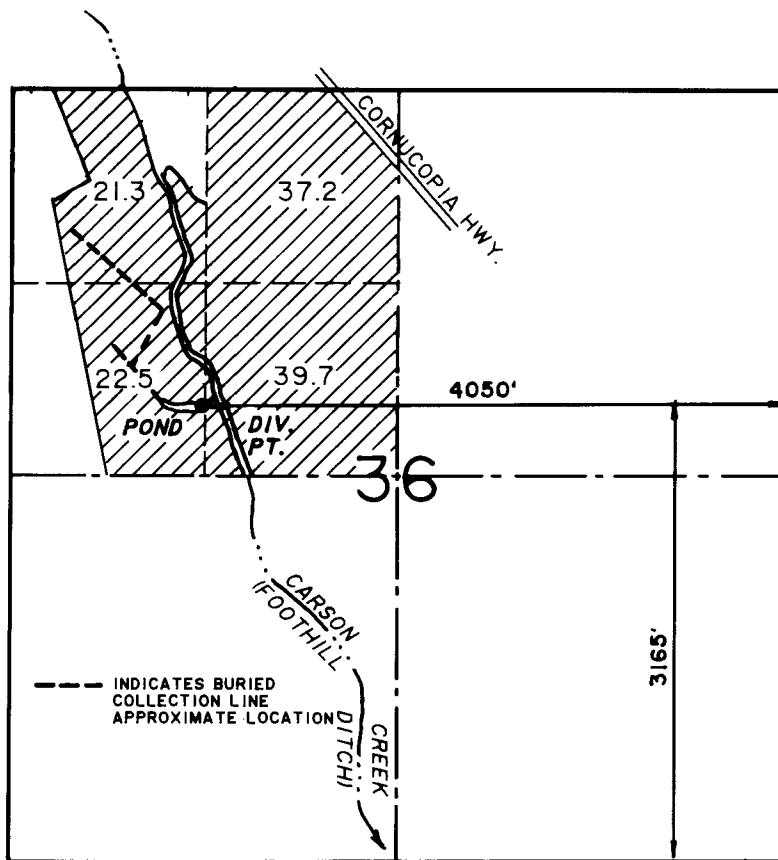

SCALE 1" = 1320'

THE PURPOSE OF THIS MAP IS FOR IDENTIFYING THE LOCATION OF THE WATER RIGHT ONLY AND IS NOT INTENDED TO PROVIDE LEGAL DIMENSIONS OF PROPERTY OWNERSHIP LINES.

### FINAL PROOF SURVEY

Application No. G-11801 Permit No. G-10902

IN NAME OF

HENRY W. HARRIS

Surveyed OCTOBER 12, 1993

