


SEC. 28, T.15S., R.10E., W.M.
DESCHUTES COUNTY, OREGON
TAX LOT 151000 00 03300

SCALE 1" = 400'

N

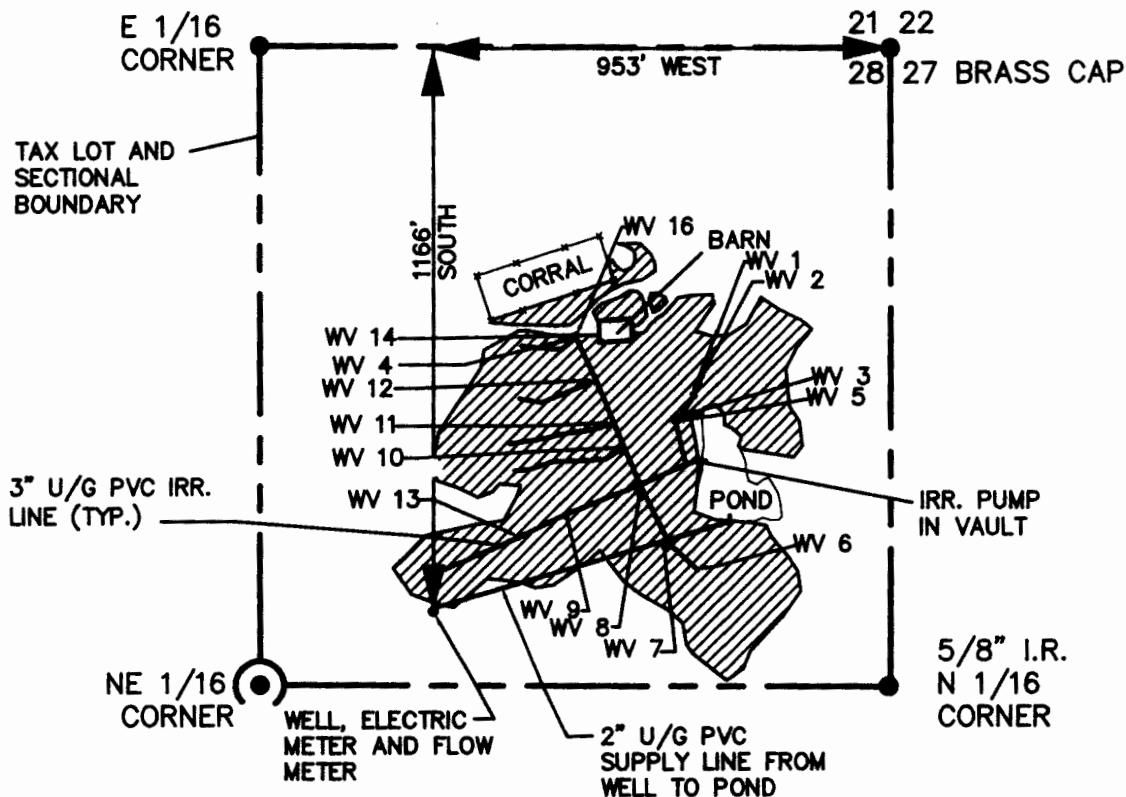

LEGEND


IRRIGATED AREA (9.1 AC.)



RECEIVED

WATER RESOURCES DEPT
SALEM, OREGON

FINAL PROOF SURVEY FOR
CLAIM OF BENEFICIAL USE
APPLICATION G 13262
PERMIT G 12577
SEPTEMBER 10, 2010

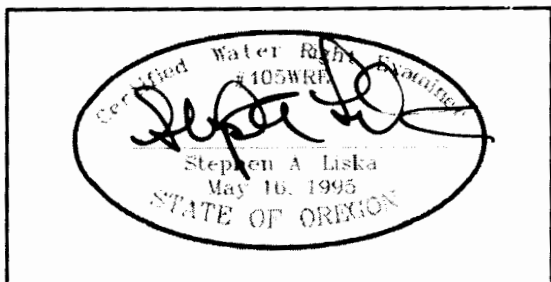

THIS MAP IS NOT INTENDED TO PROVIDE
LEGAL DIMENSIONS OR LOCATIONS OF
PROPERTY OWNERSHIP LINES.