

This map is not intended to provide legal dimensions or locations of property ownership lines.


# WINKLE RESERVOIR FINAL PROOF SURVEY

**RECEIVED**

JUL 10 2012

WATER RESOURCES DEPT  
SALEM, OREGON

T13S R5W, W.M.

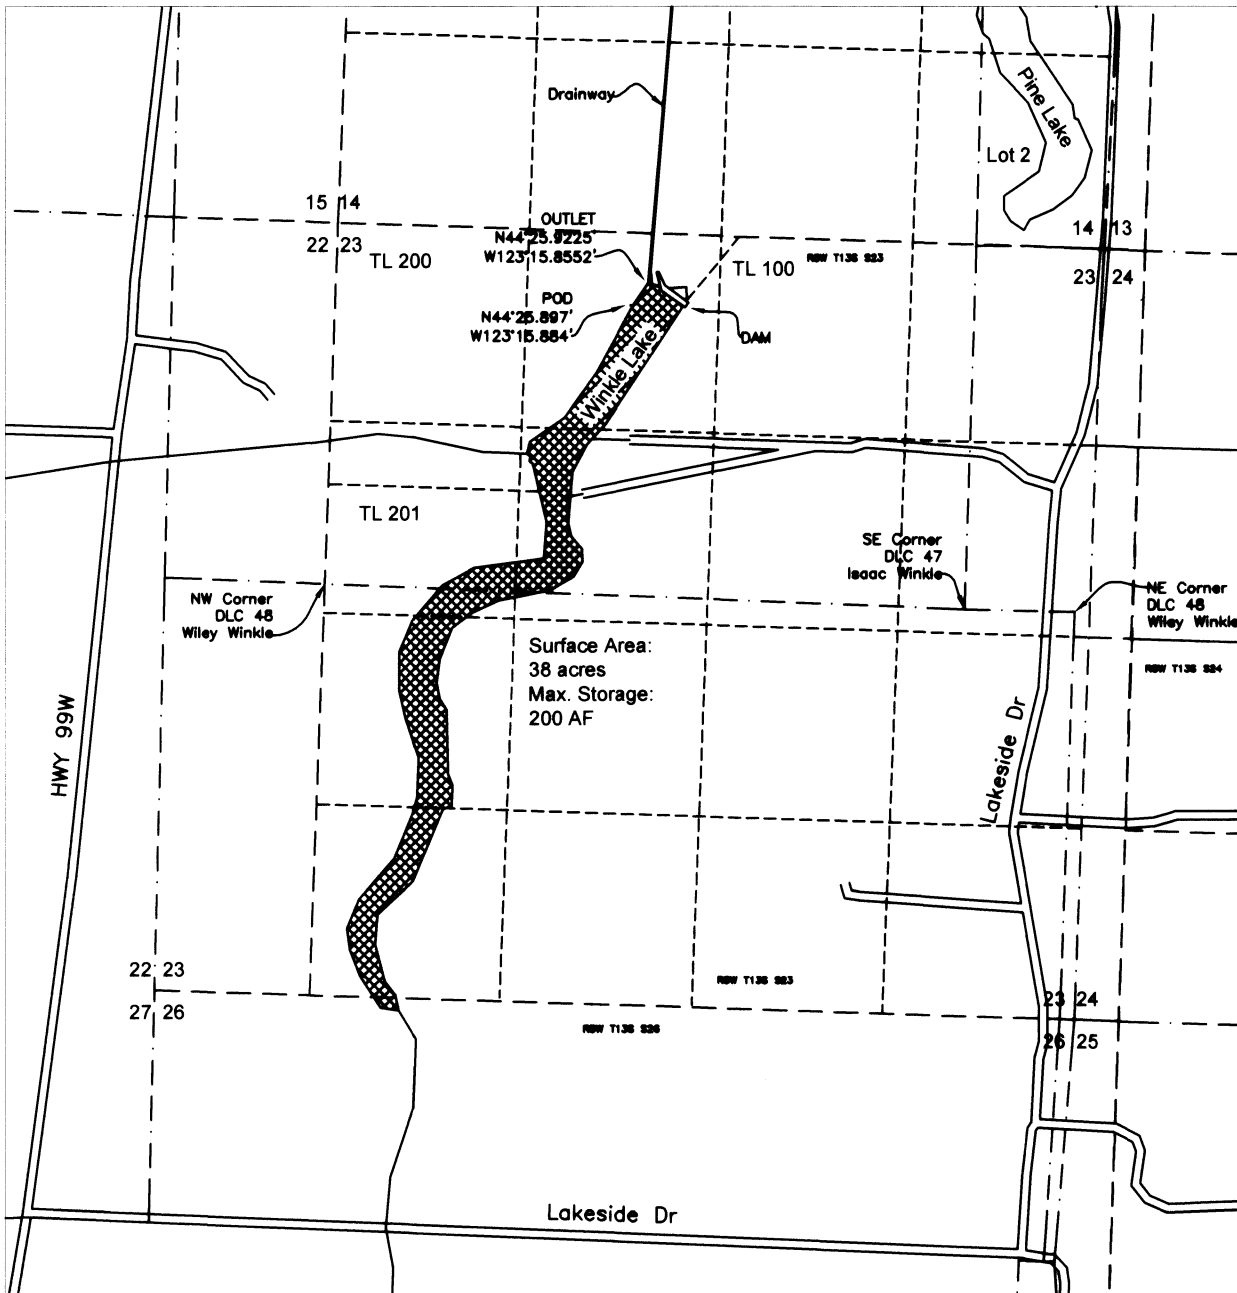

In the name of

**Greenberry Irrigation  
District**

Application #R-84502  
Permit #R-13201

28 80




Prepared by  
**Walter L. Trimmer**  
CWRE #332  
**Trimmer Engineering Inc.**  
3924 NW Walunt Place  
Corvallis, OR 97330  
541-754-2819  
trimmerw@gmail.com

Scale 1" = 1320'

June 7, 2012

Layout: Winkle  
File: GIDstorage.dwg  
Based on USGS  
Greenberry Quad

DWG 1 of 1

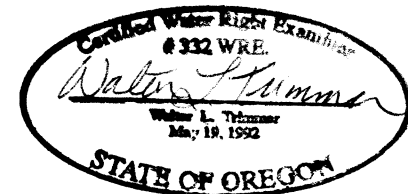

EXP 6/30/2012

Dam Loc Measured Distance 4950' N & 3050' W fr SE c, Sec 23  
mfb/wrd 1-27-17