

RECEIVED


JUL 10 2012

# WHITAKER RESERVOIR FINAL PROOF SURVEY

This map is not intended to provide legal dimensions or locations of property ownership lines.

WATER RESOURCES DEPT  
SALEM, OREGON


T13S R5W, W.M.

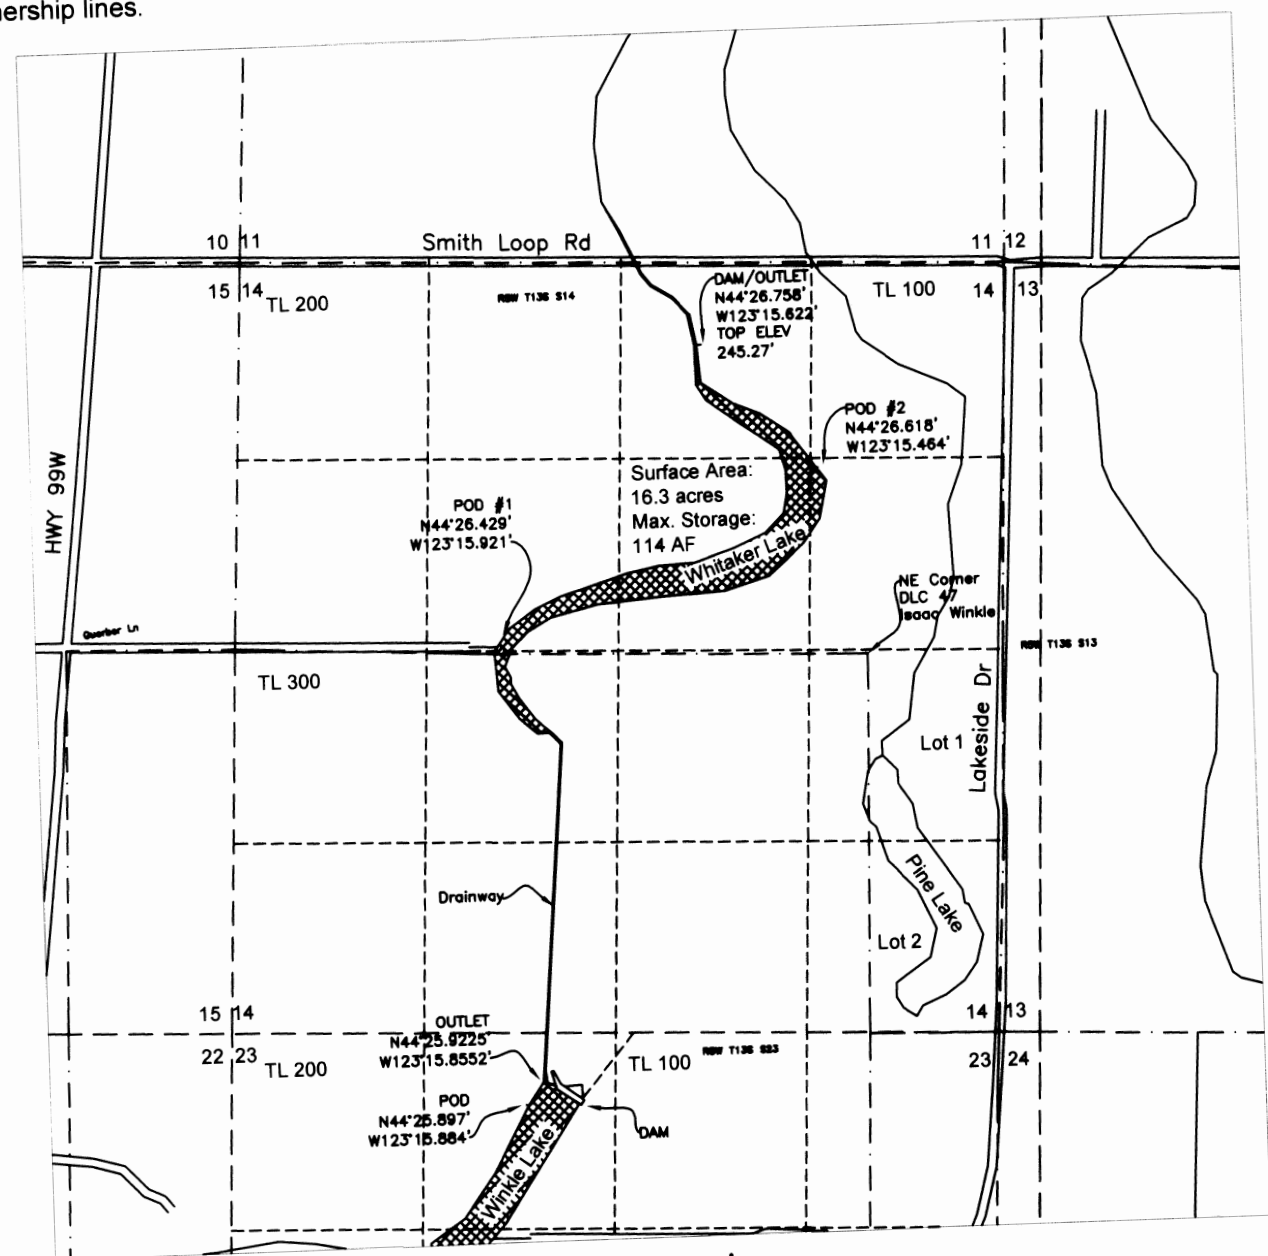

In the name of

**Greenberry Irrigation District**

Application #R-84529  
Permit #R-13202

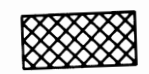

Prepared by  
**Walter L. Trimmer**  
CWRE #332  
**Trimmer Engineering Inc.**  
3924 NW Walunt Place  
Corvallis, OR 97330  
541-754-2819  
trimmerw@gmail.com

Scale 1" = 1320'

June 7, 2012

Layout: Whitaker  
File: GIDstorage.dwg  
Based on USGS  
Greenberry Quad

DWG 1 of 1



EXP 6/30/2012

Dam Loc Measured Distance 4900' N; 2400' W fr SEC, sec 14  
mfj  
wrd 1-27-17