


T.6S., R.3W., W.M.

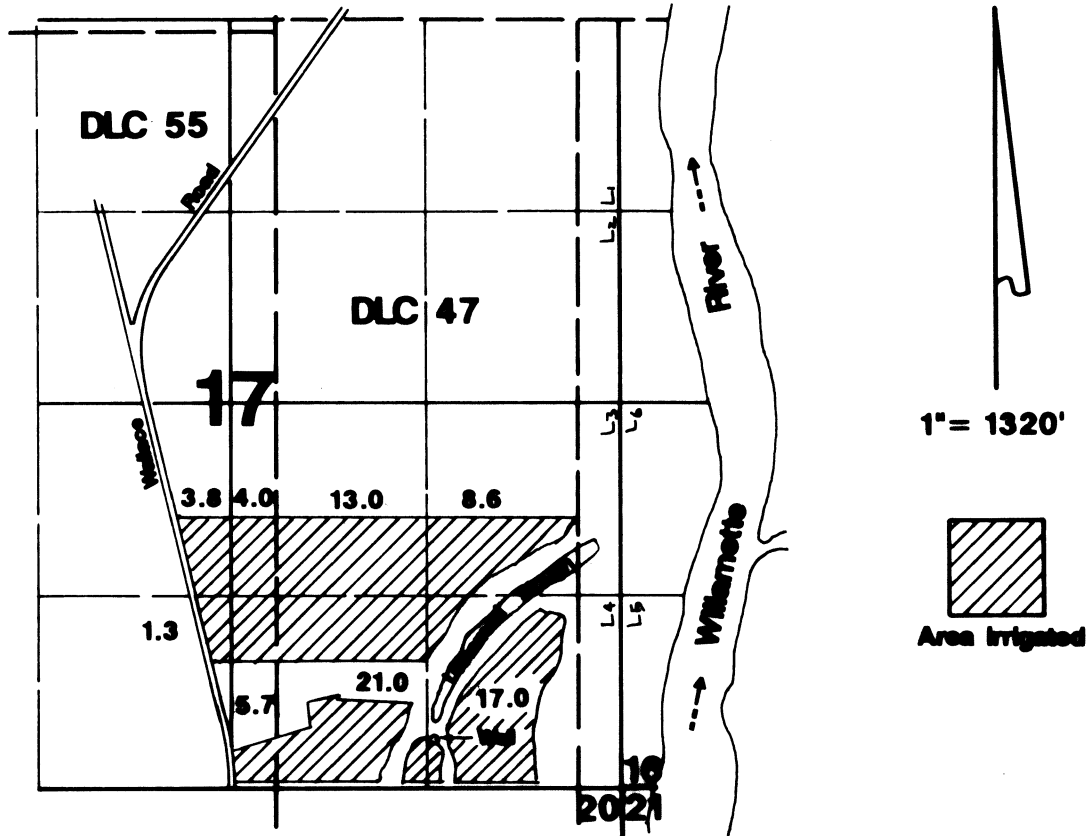

Well located 350'N & 1250'W from SE corner Section 17.

RECEIVED
MAY 15 1993


Final Proof Survey

Application #: G-11963 Permit #: G-11236

In Name of

Berend Faber

Surveyed on August 15, 1993 by James Grimm

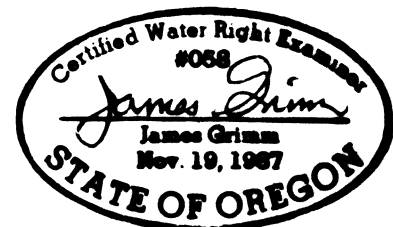

THIS MAP WAS PREPARED FOR THE PURPOSE OF IDENTIFYING THE LOCATION OF A WATER POINT ONLY AND IS NOT INTENDED TO PROVIDE LEGAL DIMENSIONS OR LOCATION OF PROPERTY OWNERSHIP LINES.