
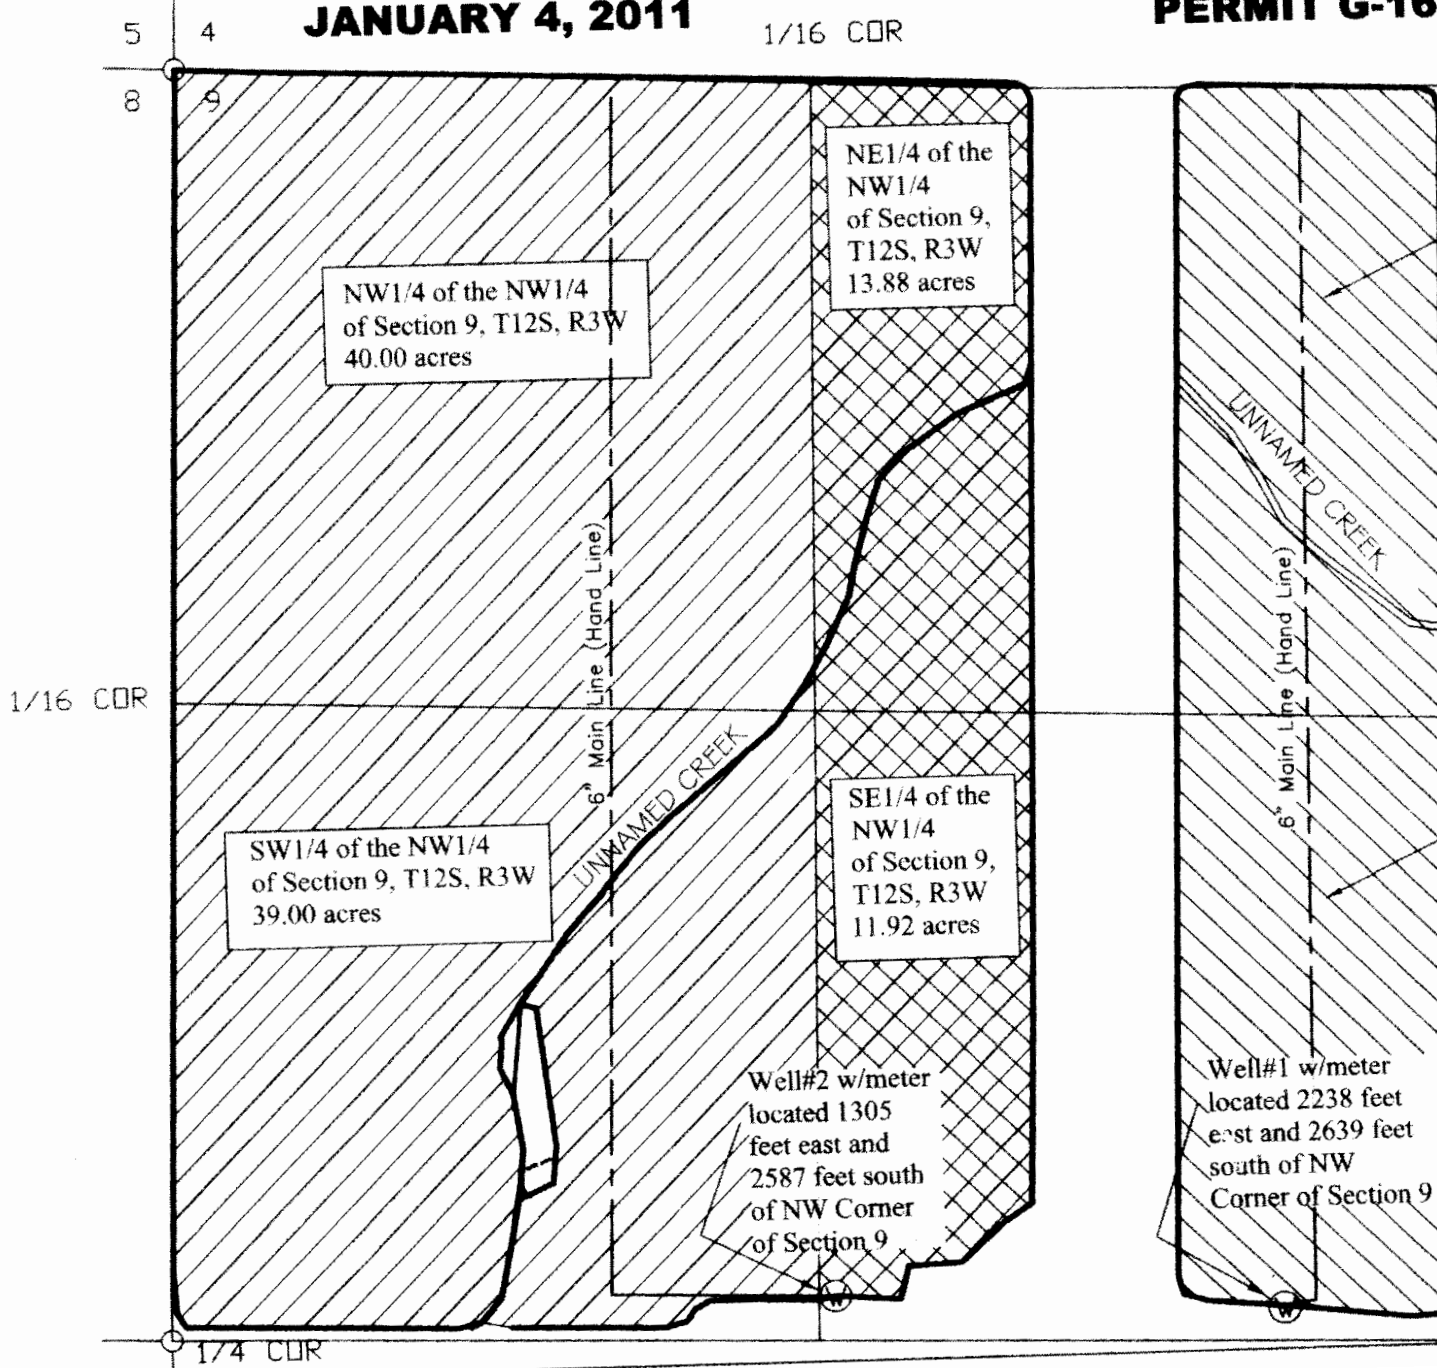
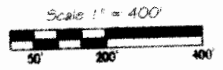



**CLAIM OF BENEFICIAL USE MAP**  
**D.K.T.K., LLC**  
**TAX LOT 200 MAP 12-3W-9**  
**JANUARY 4, 2011**

**APPLICATION G-16912**  
**PERMIT G-16391**

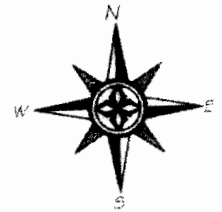

NE1/4 of the NW1/4  
of Section 9, T12S, R3W  
16.60 acres

NW1/4 of the NW1/4  
of Section 9, T12S, R3W  
40.00 acres

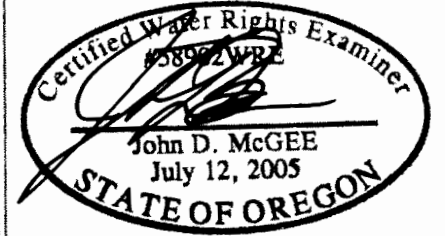

**RENEWAL DATE: 12/31/2012**



THIS MAP IS NOT INTENDED TO  
PROVIDE LEGAL DIMENSIONS OR  
LOCATION OF PROPERTY  
OWNERSHIP LINES.

SE1/4 of the NW1/4  
of Section 9, T12S, R3W  
15.76 acres

SW1/4 of the NW1/4  
of Section 9, T12S, R3W  
39.00 acres

SE1/4 of the  
NW1/4  
of Section 9,  
T12S, R3W  
11.92 acres

**LEGEND**

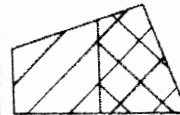-  IRRIGATION AREA WELL #2
-  IRRIGATION AREA WELL #1

IRRIGATION AREAS COMPUTED BASED ON GPS SURVEY