



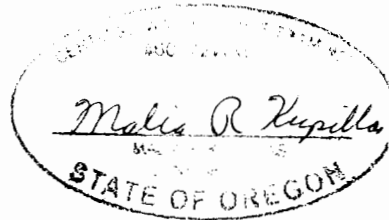


# T.5S. R.3W. Section 28, W.M.

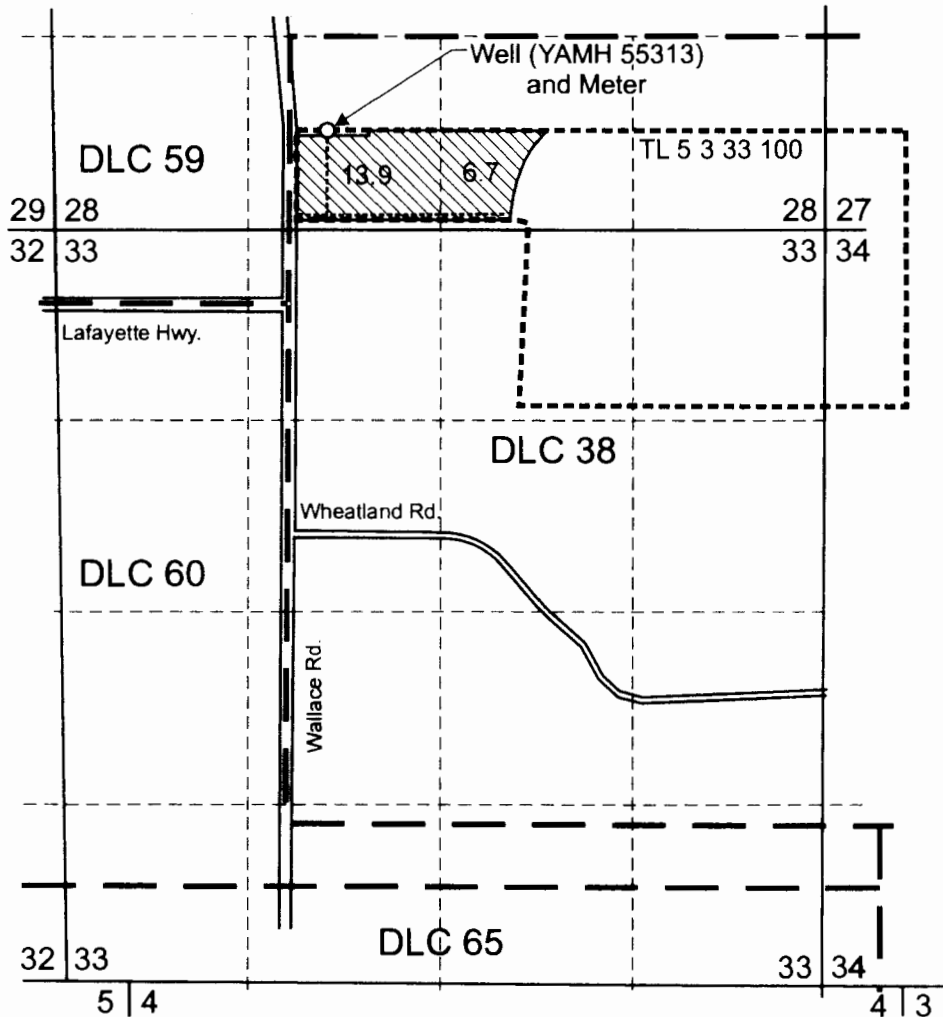

Well (YAMH 55313) is located 1,200 feet north and 265 feet east from the NE corner, Adam Matheny DLC 60.

-  Area (20.6 Acres) to be irrigated.
-  Tax lot boundary
-  Mainline



EXPIRATION DATE 6/30/13

Scale: 1" = 1,320'



This map was prepared for the purpose of identifying the location of a water right only and is not intended to provide legal dimensions or location of property ownership lines.



COBUG17248map.cdr

Pacific Hydro-Geology Inc.

8/2011

**Claim of Beneficial Use Map**  
Application G-17248, Permit G-16699

Carlton Nursery Co. LLC  
T.5S. R.3W. Section 28, W.M.