

RECEIVED

WATER RESOURCES DIVISION  
SALMON DIVISION

CLAIM OF BENEFICIAL USE (DOMESTIC)

FOR: DAVID ALDRIDGE

BY: DUANE W. KIRBY

T 27S, R3W, WM SEC 2

TAX LOT 1502


APPLICATION NO S-86771

PERMIT NO S-54474

METER IS LOCATED IN GARAGE  
FISH SCREEN LOCATED AT THE POD

SCALE 1" = 400'

12-03

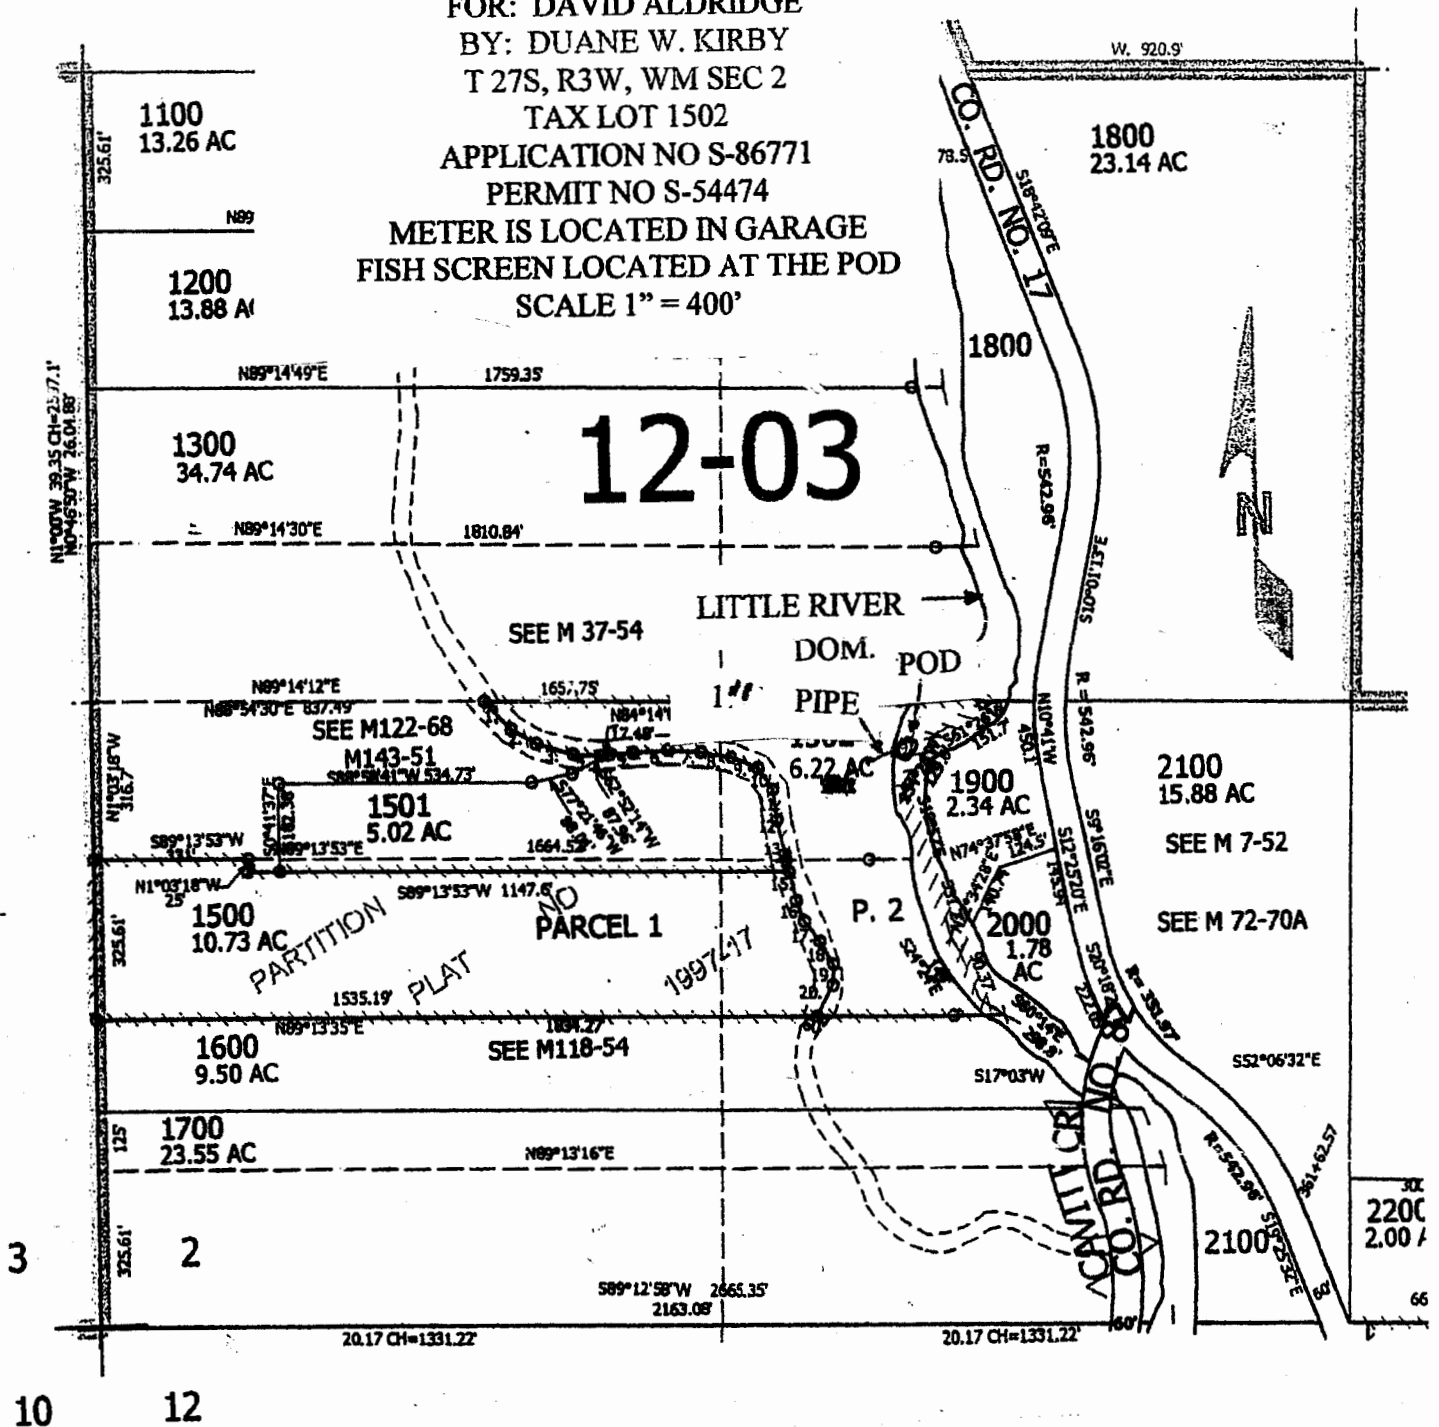

POD is located 1210 ft. N. and 975 ft. W. from the S1/4 corner of Sec. 2

THE PURPOSE OF THIS MAP IS TO IDENTIFY THE LOCATION OF THE WATER RIGHT. IT IS NOT INTENDED TO PROVIDE INFORMATION RELATIVE TO THE LOCATION OF PROPERTY OWNERSHIP BOUNDARY LINES.

Certified Water Right Examiner  
#214 WRE  
*Duane W. Kirby*  
Duane W. Kirby  
May 30, 1989  
STATE OF OREGON