

T36S R6W Sec 5

JOSEPHINE COUNTY


1" = 400'

This map was prepared for assessment purposes only.

RECEIVED

MAY 09 2007

WATER RESOURCES DEPT
SALEM OREGON

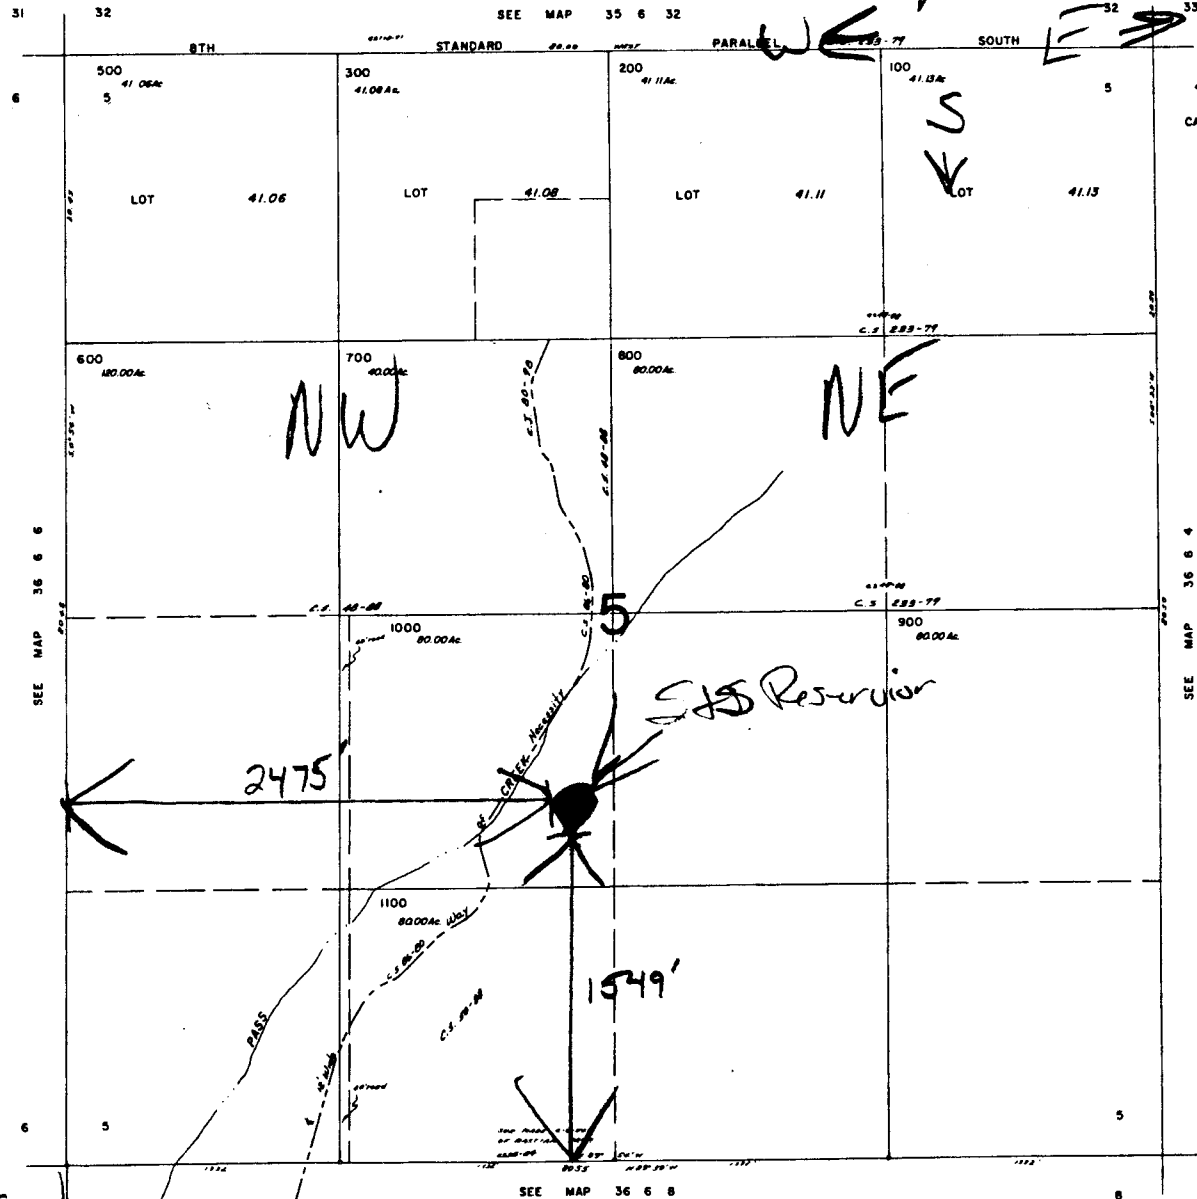

RECEIVED

APR 23 2007

WATER RESOURCES DEPT
SALEM, OREGON

SAS Reservoir is
2475' east from the
Southwest corner and
1549' north from the
Southwest corner

SW
Corner

36 6 5

app no R-86852 Permit no R-14475