

# FINAL PROOF SURVEY


RECEIVED BY OWRD

Scott and Sara Jane Moore  
Transfer No. 11274

JUN 08 2016

Township 13 South, Range 30 East, Sections 28 & 29 W.M.

SALEM, OR

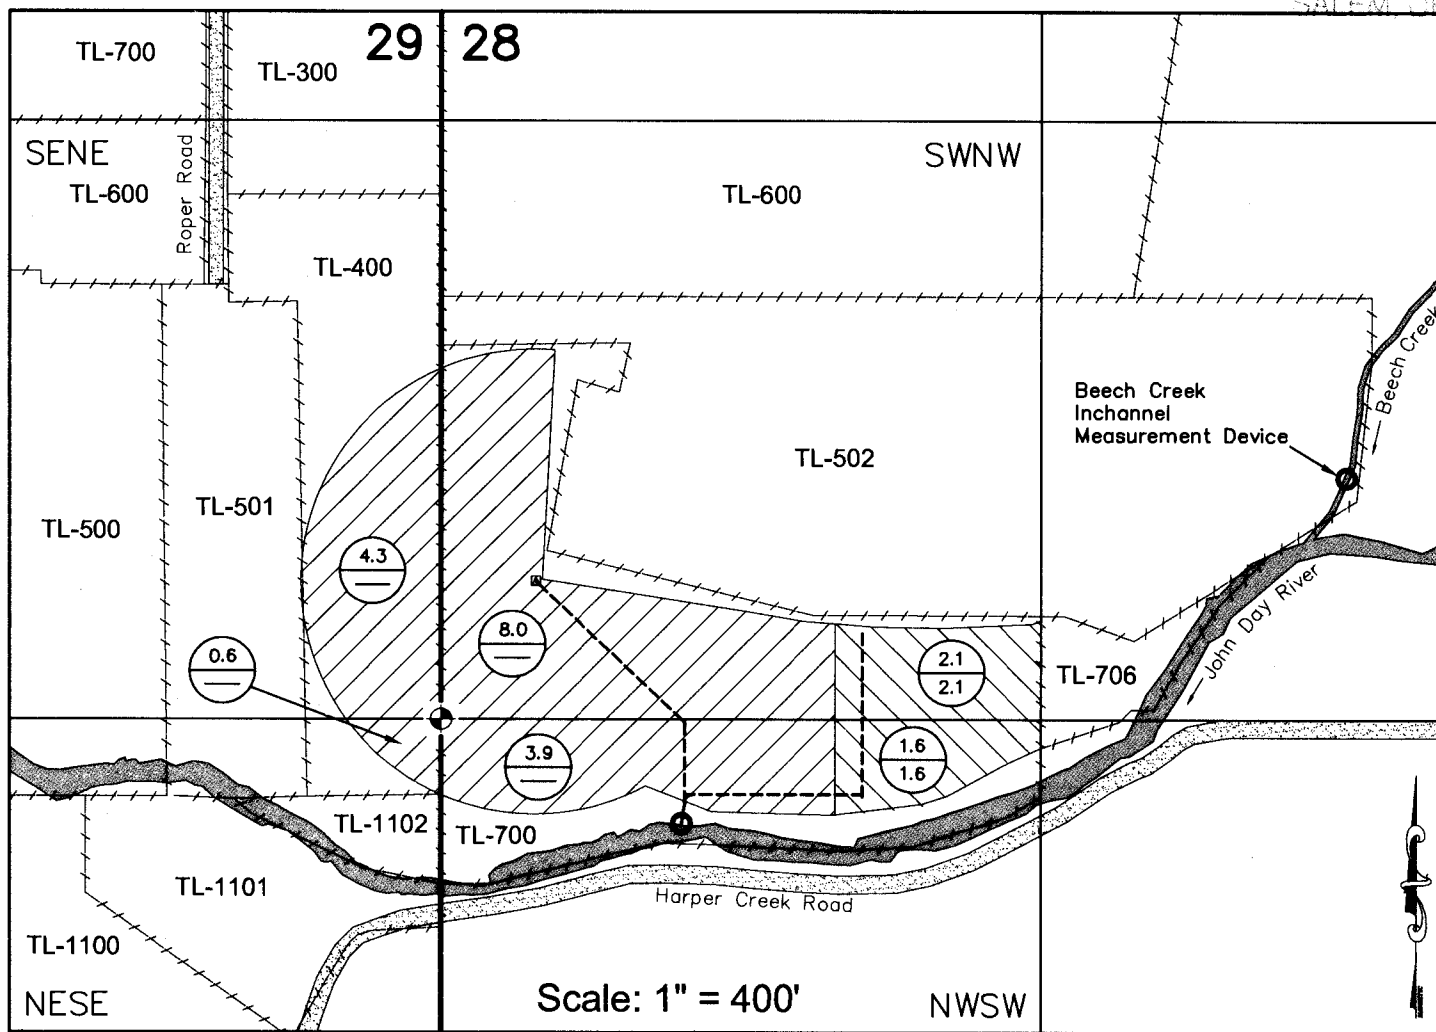

## LEGEND

● Located Section Corner      - - - Property Boundary



- - - Irrigation Pipeline

⊘ Former Certificate No. 87596 (Beech Creek)

⊘ Former Certificate Nos. 52195 and 88101 (John Day River)

⊘ Primary Acres

⊘ Supplemental Acres

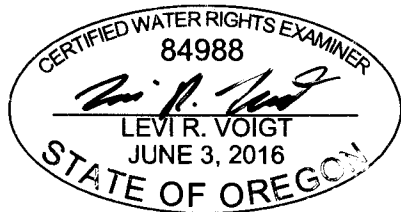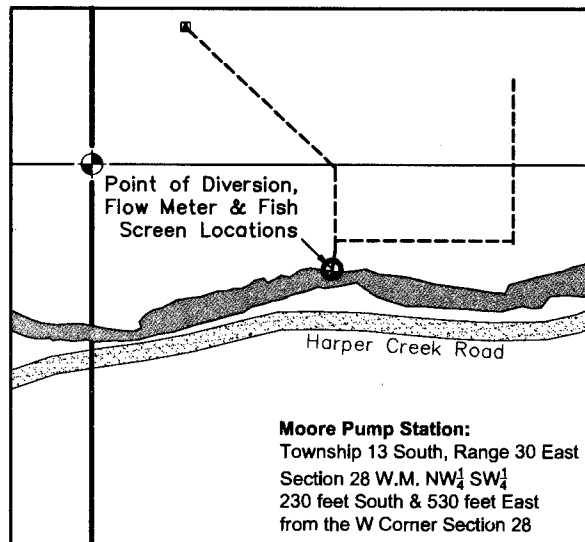

RENEWS: 6-30-18

This map is not intended to provide legal dimensions or location of property ownership lines.