



REC'D APR 16 2004

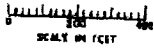


WORK COPY

Scale 1" = 400 FT

Pond located 300' South and 400' West of NE 1/16 Corner. T5N R27 E Sec. 21 SW 1/4 of NE 1/4

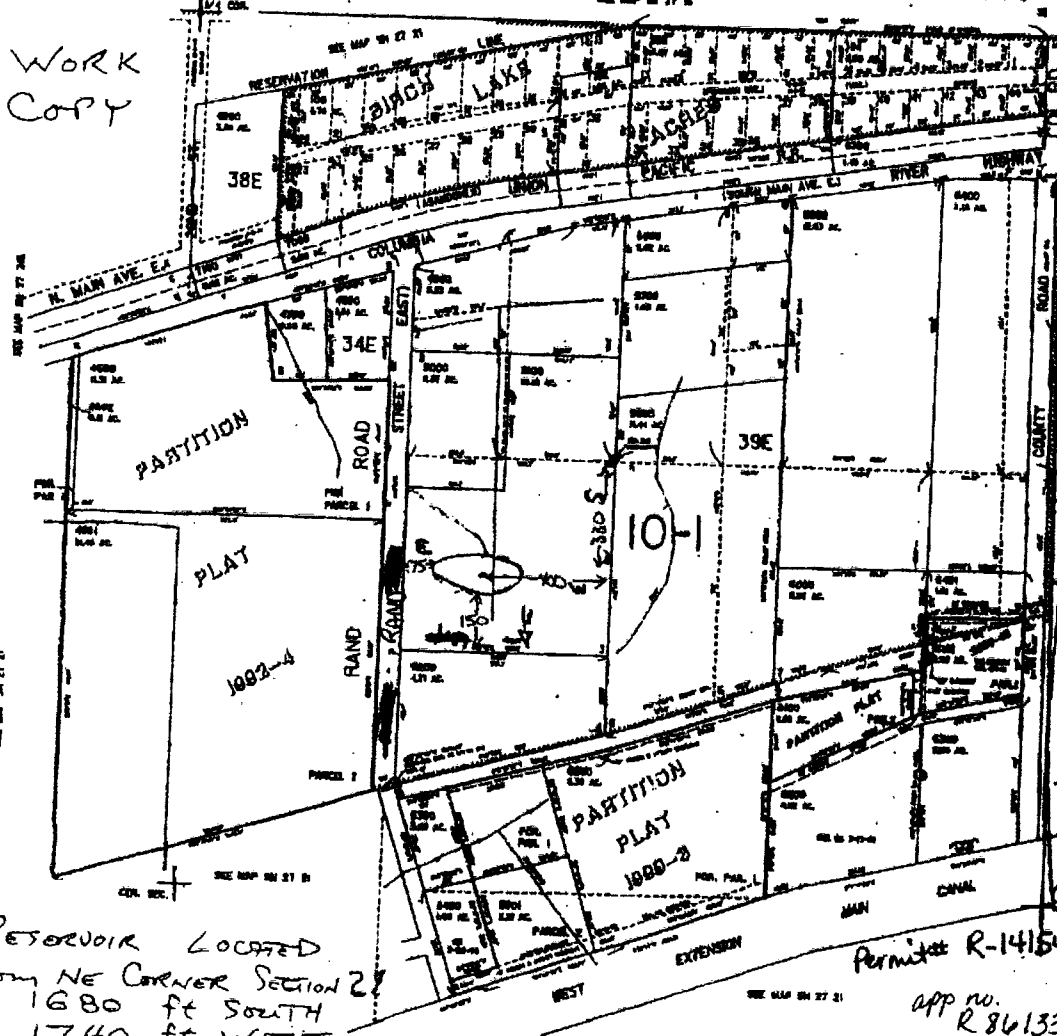

Map Full size Max Copy Part of Full size Map.

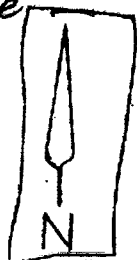

Pond located 330' South and 400' West of NE 1/16 Corner of Sec. 21 T5N R27 East SW 1/4 of NE 1/4 Tax Lot 5700

RESERVOIR LOCATED from NE CORNER SECTION 21 1680 ft SOUTH 1740 ft WEST

Permit R-14154 app no. R86133

RECEIVED BY OWRD

AUG 01 2016

SALEM, OR

