



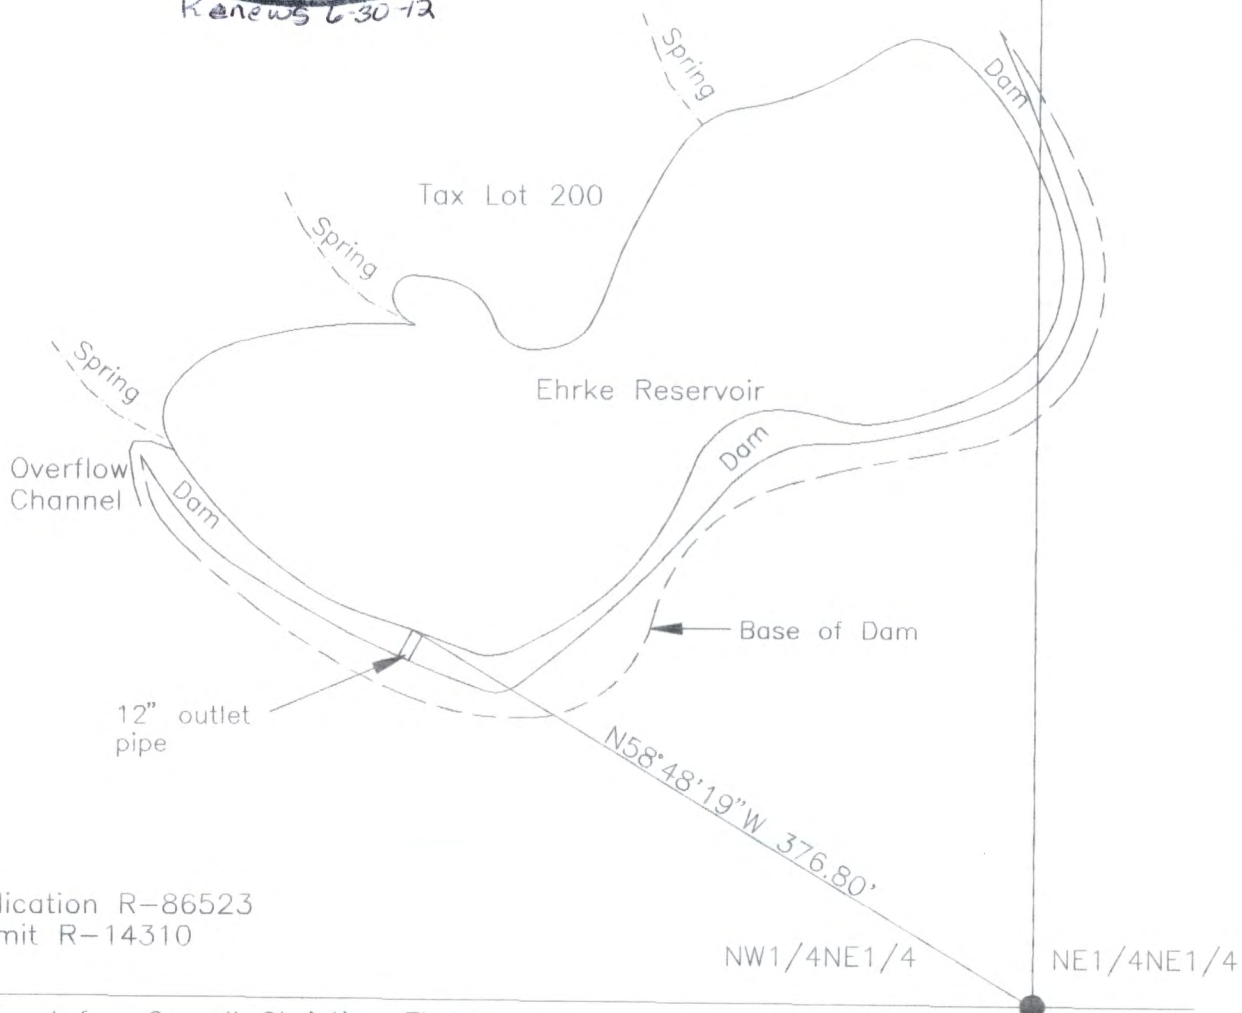

Claim of Beneficial Use Map
NE 1/4 Section 1, T.37S. R.20E., W.M.
Lake County, Oregon

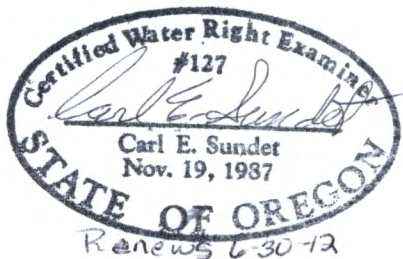

Application R-86523
Permit R-14310

Prepared for: Carroll Christian Ehrke
Prepared by: Sundet & Associates
P.O. Box 1228
Lakeview, OR 97630
(541)947-3293

February 2011 Dr. #EPONDFP

This map is for the purpose of identifying the location of the water right only and has no intent to provide dimensions or property ownership lines.

NE 1/16 corner
Section 1
5/8" iron pin with
RLS 1664 cap

NOTE:
All permit conditions have
been met.