


DATE	REVISION	EMPLOYEE
4/30/02	PTN 400 INTO 401	LCAT479
9/29/03	DIV PIN OF 18032000-0010 INTO 1400	LCAT484
1/30/04	CANC. 100 & 200 INTO HIDDEN MEADOWS SUB.	LCAT115
2/3/04	POSITION TO B3/91 DATUM	LCAT115
5/26/06	CANC. TL'S 1502 2002 INTO PP 2006-1960	LCAT146
7/9/07	ADDED LOT 2 TO H. LARD HIGHLANDS	LCAT140

LINE TABLE

L1	74.31'	S 25'
----	--------	-------

- LEGEND**
- DISTANCE AND BEARING LINE
 - ◆ SECTION CORNER
 - ▲ APPROXIMATE LOCATION OF DIVERSION POINT
 - FROM STORAGE TANK TO DISTRIBUTION SYSTEM
 - - - FROM WELLS TO BOOSTER STATION

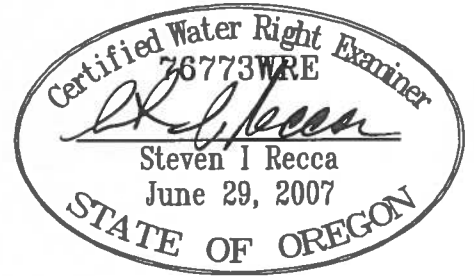

EXPIRATION DATE: 12/31/10

- THE POINT OF DIVERSIONS ARE:
- WELL # 1 2443 FEET SOUTH 20 DEGREES WEST FROM THE NE CORNER OF SECTION 21.
 - WELL # 4 3964 FEET SOUTH AND 83 DEGREES WEST FROM THE NE CORNER SECTION 21.
 - WELL # 5 2456 FEET SOUTH AND 78 DEGREES WEST FROM THE NE CORNER SECTION 21.
 - WELL # 6 2101 FEET SOUTH AND 12 DEGREES WEST FROM THE NE CORNER OF SECTION 21.
 - WELL # 7 2451 FEET SOUTH AND 9 DEGREES WEST FROM THE NE CORNER OF SECTION 21.

Application # G-15876
Permit # G-15501



T. 18 S., R. 03 W., W. M. Sec 21 and 16
Tax Lots 3100 - 5600 and 6400 - 6600
Lane County, Oregon
Hidden Meadows Land and Water Association

EGR & Associates, Inc.
Engineers, Geologists and Surveyors

2535B Prairie Road Eugene, Oregon 97402 (541) 688-8322 Fax (541) 688-8087

BASE MAPPING BY LANE COUNTY TAX MAPS 180321 and 180316. THIS MAP HAS BEEN PREPARED FOR THE SOLE PURPOSE OF IDENTIFYING THE REQUESTED WATER RIGHT LOCATION. THERE IS NO INTENT TO PROVIDE DIMENSIONS OR LOCATIONS OF PROPERTY OWNERSHIP LINES.

COBU MAP 0493