


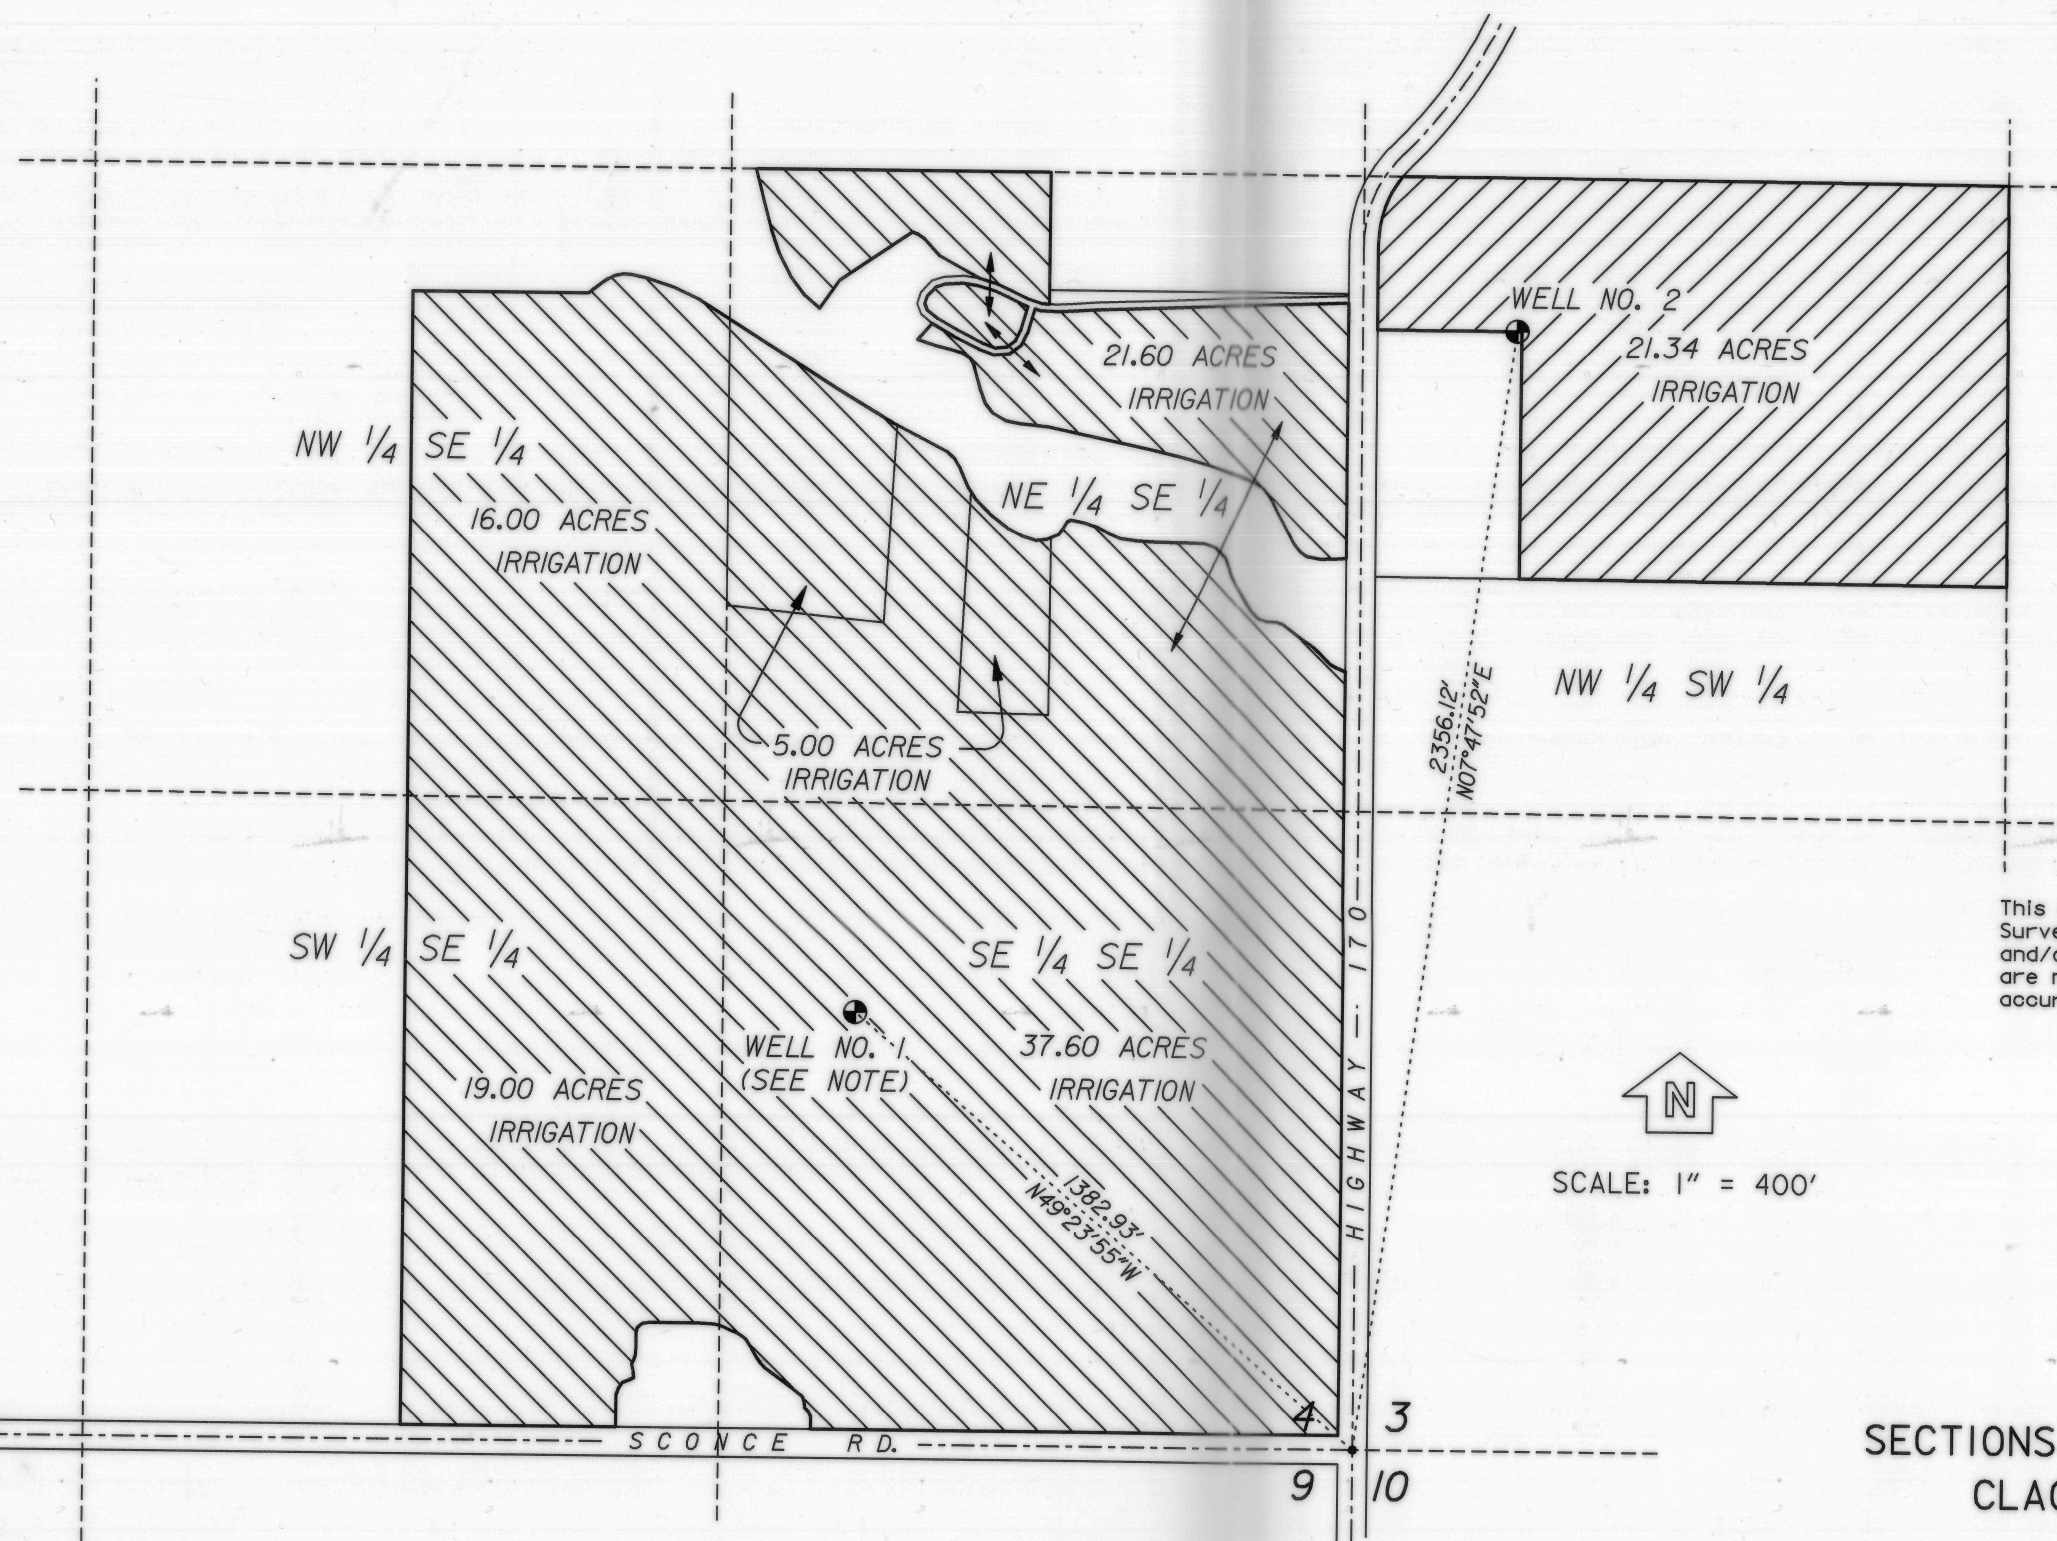


NOTE:

UNDER CERTIFICATE NO. 45466, WELL NO. 1
IS PRIMARY SUPPLY FOR:
NE 1/4 SE 1/4 SECTION 4 - 23.0 ACRES
NW 1/4 SE 1/4 SECTION 4 - 16.0 ACRES
SW 1/4 SE 1/4 SECTION 4 - 19.0 ACRES
SE 1/4 SE 1/4 SECTION 4 - 37.6 ACRES
AND IS SUPPLEMENTAL SUPPLY FOR:
NE 1/4 SE 1/4 SECTION 4 - 5.0 ACRES

LEGEND

PRIMARY SUPPLY
 SUPPLEMENTAL SUPPLY

This drawing is an exhibit for a Final Proof Survey. It is not a Land Survey. Property lines and/or other lines of occupation shown hereon are not represented by the undersigned to meet accuracy standards of Land Surveys.

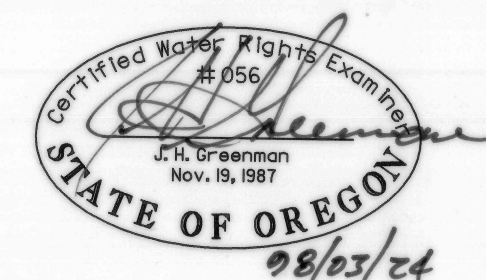

SCALE: 1" = 400'

SECTIONS 3 AND 4, T.5S., R.1E., W.M.
CLACKAMAS COUNTY, OREGON

Application No. G-13954
Permit No. G-13033

RECEIVED

MAR 20 1998

WATER RESOURCES DEPT.
SALEM, OREGON



**HANER, ROSS &
SPORSEEN, INC.**

15 S.E. 82ND DRIVE
GLADSTONE, OREGON 97027

**ROSELAWN SEED INC.
FINAL PROOF SURVEY**

878