


RECEIVED


OCT 12 1999

WATER RESOURCES DEPT.  
SAVANA, OREGON

TOWNSHIP 4 SOUTH, RANGE 1 WEST, W.M.

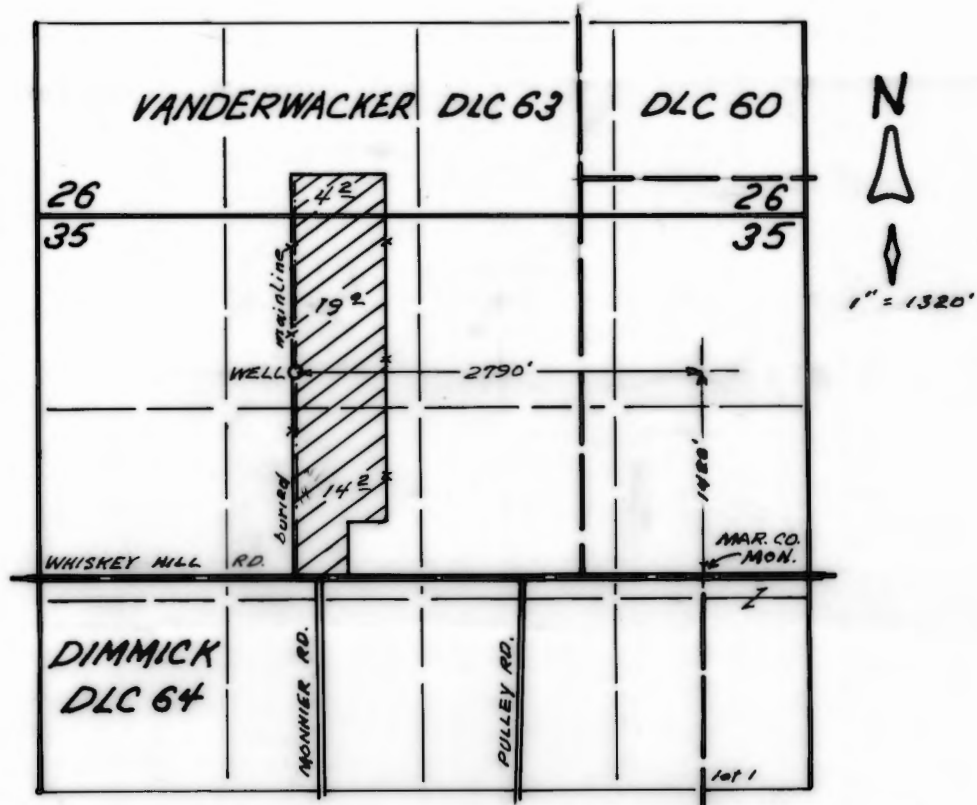

FINAL PROOF SURVEY  
 UNDER  
 APPL. No. G-13893, PER. No. G-12425  
 IN NAME OF  
 MICHAEL OVCHINNIKOFF  
 SEP. 6, 1999

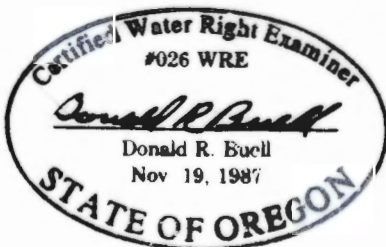

THIS MAP WAS PREPARED FOR THE PURPOSE OF IDENTIFYING THE LOCATION OF A WATER RIGHT ONLY AND IS NOT INTENDED TO PROVIDE LEGAL DIMENSIONS OR LOCATION OF PROPERTY OWNERSHIP LINES.