


RECEIVED
 SEP 30 1994
 WATER RESOURCES DEPT.
 SALEM, OREGON



This drawing is a Final Proof Survey for a Ground Water Right. It is not a Land Survey. Property lines and/or other lines of occupation shown hereon are not represented by the undersigned to meet accuracy standards of Land Surveys.

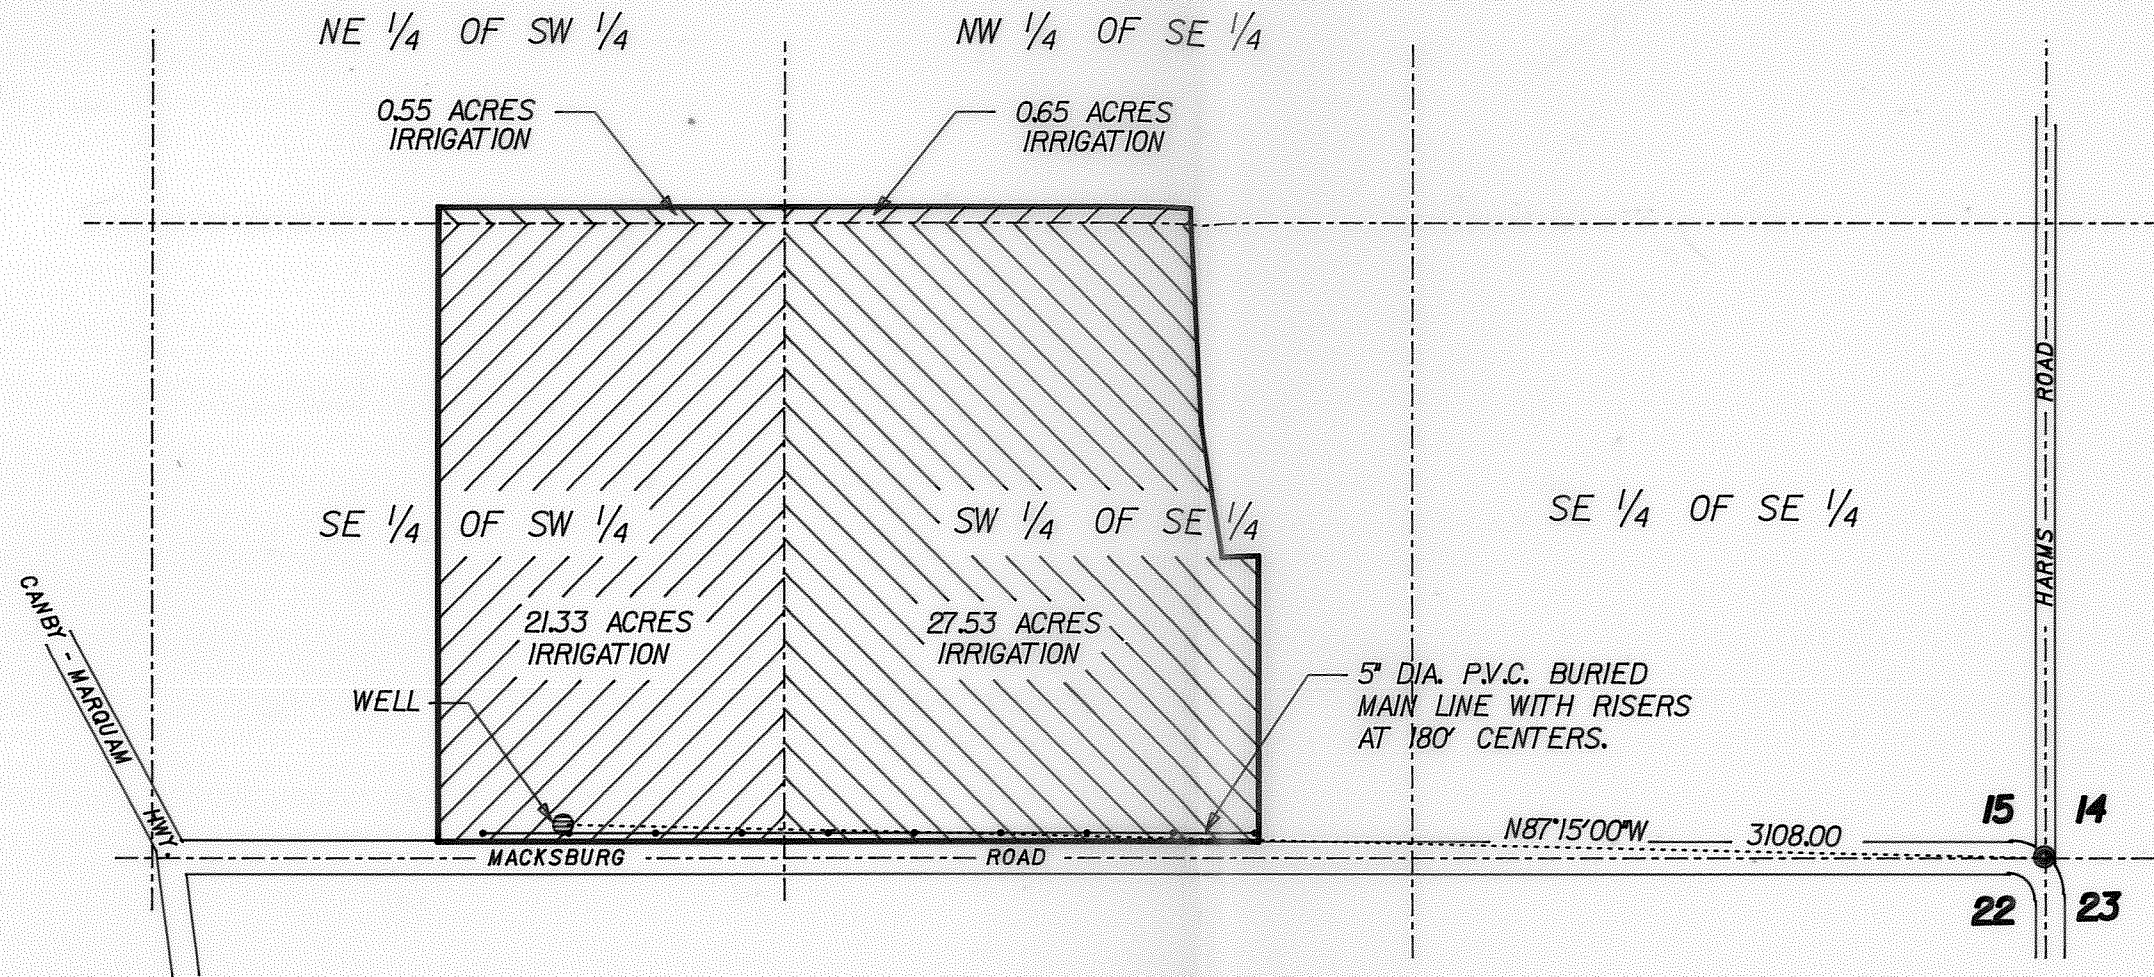

SCALE: 1" = 400'

**SECTION 15, T.4S., R.1E., W.M.
 CLACKAMAS COUNTY, OREGON**

Application No: G-12884

Permit No: G-11633

Certified Water Rights Examiner
 #056
J. H. Greenman
 J. H. Greenman
 Nov. 19, 1987
 STATE OF OREGON
 94/09/22

HRS
**HANER, ROSS &
 SPORSEEN, INC.**
 15 S.E. 82ND DRIVE
 GLADSTONE, OREGON 97027

**FOUR MILE NURSERY
 GROUND WATER RIGHT
 FINAL PROOF SURVEY**

630/D

File: 630rnl.dgn edr 9/22/94