



FINAL PROOF MAP OF PERMIT 14057 FOR SCOTT HENDRICKS T6N, R35E

LEGEND


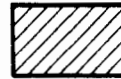


AREA IRRIGATED

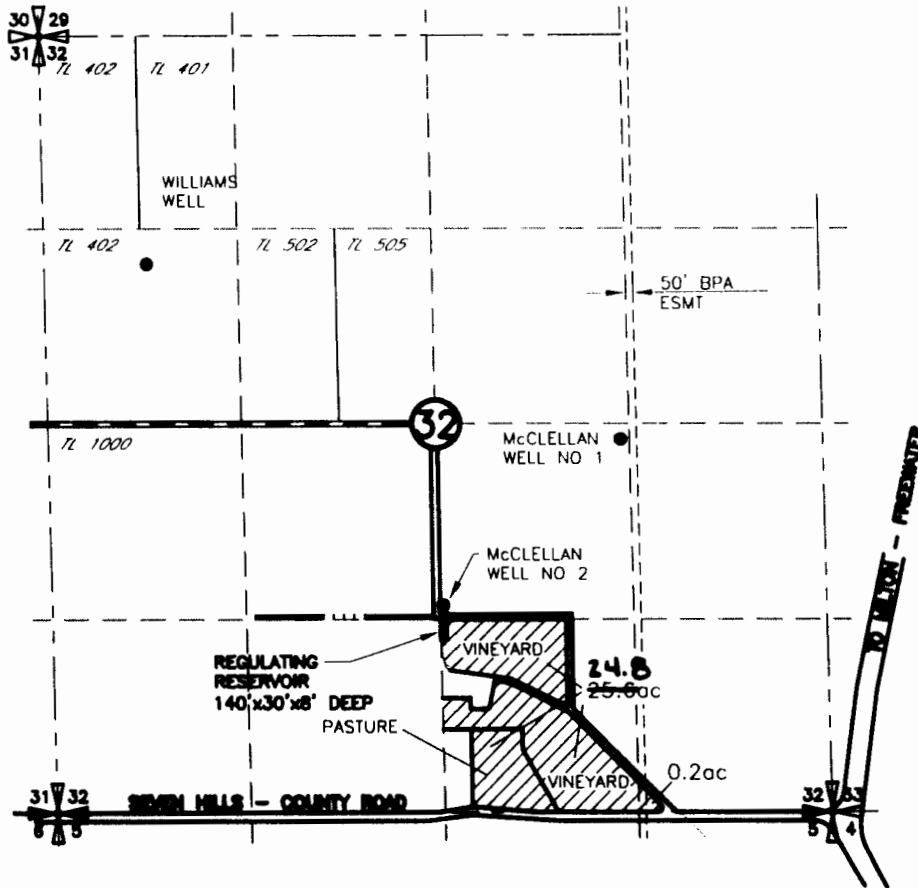

RECEIVED
SCOTT HENDRICKS
14057
T6N, R35E

POINTS OF APPROPRIATION
McCLELLAN WELL NO 2
LOCATED 1418' N AND 22.1' E FROM THE
S 1/4 COR SEC 32

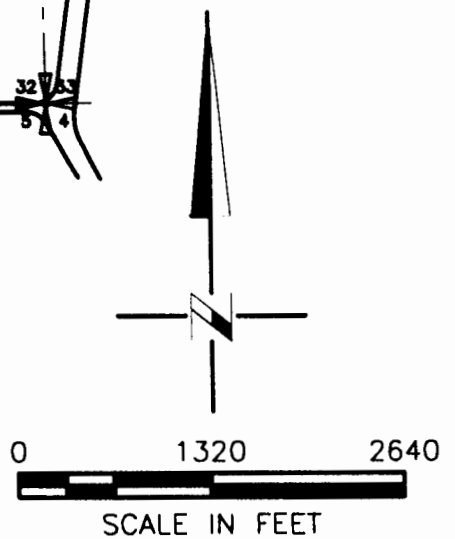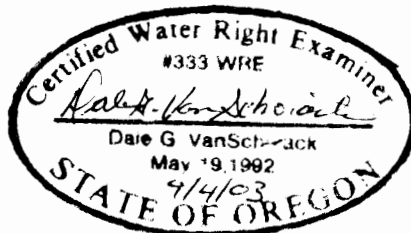

DRAWING: H:\CAD\AG\3522\171\3522171p3.dwg
PRINTED BY: rogerw on 09/04/03 08:16 AM

9/02/03

NOTE:
THE PURPOSE OF THIS MAP IS TO IDENTIFY THE APPROXIMATE LOCATION
OF THE WATER RIGHT. IT IS NOT INTENDED TO PROVIDE INFORMATION
RELATIVE TO THE LOCATION OF PROPERTY OWNERSHIP BOUNDARY LINES.



Map has been amended by CWED to adjust acreage in swse. 10/4/03 11:16