


Township 4 South, Range 1 West, W.M.  
Portions of Sections 5 and 8

RECEIVED

AUG 18 1994

WATER RESOURCES DEP  
SALEM, OREGON

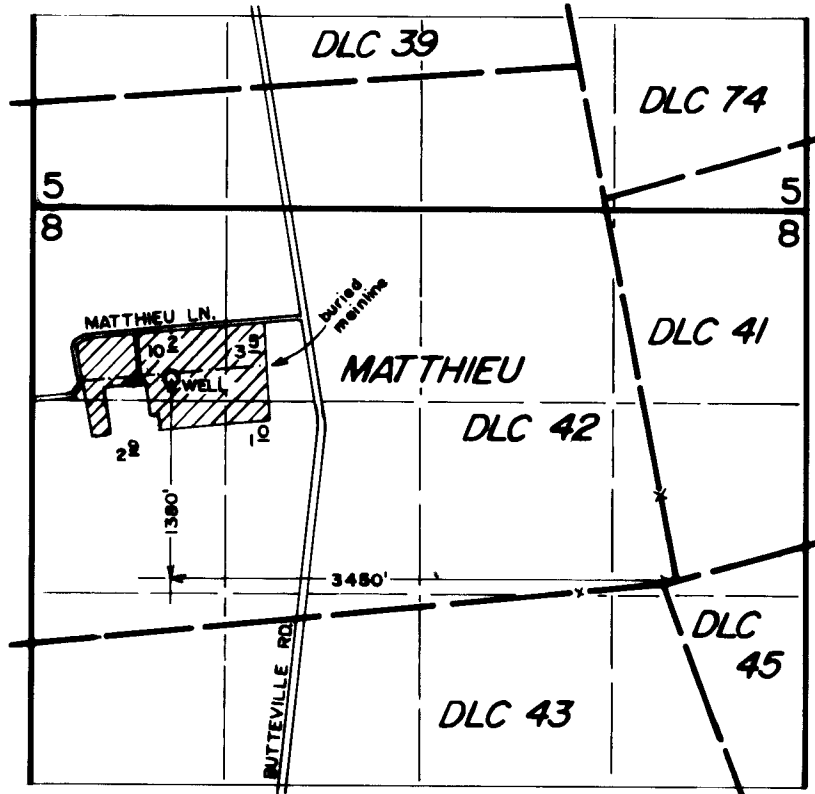


FINAL PROOF SURVEY  
under

Appl. No. G-12397, Per. No. G-11402  
in name of

BRANT POPMA

August 9, 1994

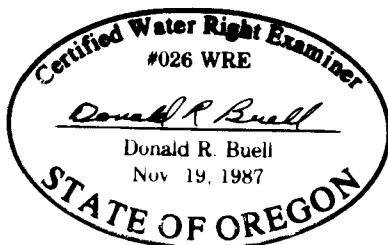

THIS MAP WAS PREPARED FOR THE PURPOSE OF IDENTIFYING THE LOCATION OF A WATER RIGHT ONLY AND IS NOT INTENDED TO PROVIDE LEGAL DIMENSIONS OR LOCATION OF PROPERTY OWNERSHIP LINES.